

BILL DODD, CHAIR

Napa County and Cities

SCOTT HAGGERTY, VICE CHAIR

Alameda County

TOM AMMIANO

City and County of San Francisco

TOM AZUMBRADO

U.S. Department of Housing and Urban Development

TOM BATES

Cities of Alameda County

BOB BLANCHARD

Sonoma County and Cities

DEAN J. CHUCities of Santa Clara County

DAVE CORTESE

Association of Bay Area Governments

DORENE M. GIACOPINI
U.S. Department of Transportation

FEDERAL D. GLOVER

Contra Costa County

ANNE W. HALSTED

San Francisco Bay Conservation and Development Commission

STEVE KINSEY

Marin County and Cities

SUE LEMPERT Cities of San Mateo County

JON RUBIN

San Francisco Mayor's Appointee

BIJAN SARTIPI

State Business, Transportation and Housing Agency

JAMES P. SPERING
Solano County and Cities

ADRIENNE J. TISSIER

San Mateo County

AMY WORTH

Cities of Contra Costa County

KEN YEAGER

Santa Clara County

STEVE HEMINGER Executive Director

ANDREW B. FREMIER
Deputy Executive Director

February 22, 2010

Addendum No. 1 to Invitation for Bid for Toll Bridge Signing & Striping Project

Dated February 9, 2010

Dear Contractor:

This letter is Addendum No. 1 to the Invitation for Bid for the Toll Bridge Signing & Striping Project, dated February 9, 2010. Where text is revised, deleted text is shown in strike-through format; added text is italicized. The IFB is revised as follows:

Addendum	Reference	<u>Change(s)</u>
<u>Item</u>		
1.	Section 5, Bid Form #1, Schedule of Quantities and Prices	Pages 33 and 34 are revised, as shown in Attachment 1.
2.	Section SC-8 Materials & Services, subsection 8.2 Services, page 50.	Payment The contract lump sum price paid for Construction Staking shall be considered as included in the prices paid for the various items of work and no additional compensation will be allowed thereof. and shall constitute full compensation for furnishing Construction Staking includes all labor, materials, tools, equipment and incidentals, and for doing all the-work involved in construction staking including verifications of survey data, and providing survey notes, as shown on the plans, as specified in the specifications and as directed by the Engineer.
3.	Section SC -14 Hazardous Material, subsection 14.1 Aerially Deposited Lead, last paragraph, pages 61 – 62.	Full compensation for the The Health and Safety Plan shall be considered as included in the prices for various items of work and no additional compensation shall be allowed therefore. The Health and Safety Plan includes including furnishing all the labor, materials, tools, equipment, and incidentals and for doing all the work involved in

Addendum	Reference	Change(s)
<u>Item</u>		preparing the Health and Safety Plan, including paying a Certified Industrial Hygienist, and for providing personal protective equipment, training and medical surveillance, as specified in these special conditions, and as directed by the Engineer-shall be considered as included in the lump sum price paid for Site Health and Safety Plan and no additional compensation shall be allowed therefor.
4.	Section 10-1.26 Install Removable Sign Panel Frame, page 239.	Removable sign panel frames shall be installed on existing sign structures as shown on the plans and in conformance with the provisions in Section 56-1, "Overhead Sign Structures," of the Standard Specifications and these special provisions. Sign panels and removable sign panel frames will be furnished by the State as provided in "Materials" of these special provisions. The Contractor shall furnish sign panels and removable sign panel frames as provided in "Furnish Sign" of these special provisions.
		Installing removable sign panel frames will be measured by the unit as determined from actual count in place. A unit shall consist of one removable sign panel frame with sign panels attached.
		The contract unit price paid for installing removable sign panel frame Installing removable sign panel frame shall be considered as included in the prices for Furnish Formed Panel Sign and no additional compensation shall be allowed therefore. Sign installation shall includes full compensation for furnishing all labor, materials (except sign panel and removable sign panel frame), tools, equipment, and incidentals, and for doing all the work involved in install removable sign panel frames, complete in place, including installing sign panels to the panel frames, as shown on the plans, as specified in the Standard Specifications and these special provisions, and as directed by the Engineer.
5.	Section 110-1.27 Install Sign Overlay, second paragraph/sen- tence, page 239.	Sign overlay panels will be furnished by the State as provided under "Materials" of these special provisions.

Addendum	Reference	Change(s)
<u>Item</u>		
6.	Appendix A: all plan sheets that include: "FASTRAK REQUIRED TOLL \$2.50" Signs	Replace Sign Design A with Sign Design B, as shown in Attachment 2, in all indicated plan sheets. Note: All other information on the affected plan sheets remains unchanged, except as provided in Items 7 and 8 of this Addendum #1.
7.	Appendix A: Toll Sign Plans	The following plan sheets are revised, as shown in Attachment 3: - Antioch Bridge: S-2, S-3, S-4, SD-1, SQ-1, SQ-2. - Benicia-Martinez Bridge: S-9, SD-1, SD-2, SQ-1. - Carquinez Bridge: S-4, S-9, SD-1, SQ-1. - Dumbarton Bridge: S-1, SD-1, SD-2, SQ-2. - Richmond-San Rafael Bridge: S-2, S-3, SD-1, SD-2. - San Francisco-Oakland Bay Bridge: S-3, SD-3, SD-5, SQ-2, SQ-3. - San Mateo-Hayward Bridge: SD-2. Note: Changes are identified with clouds annotated Delta 1.
8.	Appendix A, Pavement Delineation Plans	The following plan sheets are revised, as shown in Attachment 3: - Antioch Bridge: PD-4 and PDQ-1. - Richmond-San Rafael Bridge: PD-1 through PD-4, and PDQ-1; Plan sheet PD-5 is added as shown in Attachment 3. Note: Changes are identified with clouds annotated Delta 1.

The remaining provisions of the IFB, dated February 9, 2010, remain unchanged.

Any questions concerning this addendum to the IFB should be directed to Linda Lee, Project Manager, at (510) 817-5825 or llee@mtc.ca.gov.

Steve Heminger

Sincerely,

Executive Director

SH: LL

J:\CONTRACT\Procurements\Engineer&Architect\BATA\Toll Bridge Signing & Striping\Toll Bridge Sign & Stripe Add1.doc

ATTACHMENT 1 SCHEDULE OF QUANTITIES AND PRICES (revised)

The prices quoted below include all applicable taxes, fees, permits, delivery and other charges as

Item No. Item Description Unit of Measure Price Project Total	equired.				
2 Remove Pavement Marking SQFT 430 196 3 Remove Thermoplastic Traffic Stripe LF 8,865 13,998 4 Remove Pavement Marker EA 644 916 5 Remove Roadside Sign EA 20 6 Remove Sign From Electrolier EA 1 7 Remove Sign Panel EA 1 8 Relocate Roadside Sign (Wood Post) EA 1 9 Relocate Framed Sign Panel EA 1 9 Relocate Framed Sign Panel EA 2 10 Replace Sign Panel (Roadside Sign) EA 39 11 Lead Compliance Plan LS 1 12 Furnish Formed Panel Sign (Overhead) SQFT 402 219 13 Furnish Single Sheet Aluminum Sign (0.063"-Unframed) SQFT 25 15 Furnish Single Sheet Aluminum Sign (0.080"-Unframed) SQFT 25 15 Furnish Single Sheet Aluminum Sign (0.080"-Framed) SQFT 126 16 Metal (Barrier Mounted Sign) LB <th></th> <th>Item Description</th> <th></th> <th></th> <th>Project Total</th>		Item Description			Project Total
3 Remove Thermoplastic Traffic Stripe LF 8,865 13,998 4 Remove Pavement Marker EA 644 916 5 Remove Roadside Sign EA 20 6 Remove Sign From Electrolier EA 1 7 Remove Sign Pamel EcA 1 1 8 Relocate Roadside Sign (Wood Post) EA 1 9 Relocate Framed Sign Panel EA 2 10 Replace Sign Panel (Roadside Sign) EA 2 11 Lead Compliance Plan LS 1 12 Furnish Formed Panel Sign (Overhead) SQFT 402 219 13 Furnish Formed Panel Sign (Overhead) SQFT 402 219 14 Furnish Single Sheet Aluminum Sign (0.080"-Unframed) SQFT 25 15 Furnish Single Sheet Aluminum Sign (0.080"-Unframed) SQFT 25 16 Metal (Barrier Mounted Sign) LB 320 17 Roadside Sign - One Post EA 2 18 Install Sign (Strap and Saddle Bracket Method) <	1	Traffic Control System	LS	1	
4 Remove Pavement Marker EA 644 916 5 Remove Roadside Sign EA 20 6 Remove Sign From Electrolier EA 1 7 Remove Sign Panel EA 1 8 Relocate Roadside Sign (Wood Post) EA 1 9 Relocate Framed Sign Panel EA 2 10 Replace Sign Panel (Roadside Sign) EA 39 11 Lead Compliance Plan LS 1 12 Furnish Formed Panel Sign (Overhead) SQFT 402 219 13 Furnish Single Sheet Aluminum Sign (0.063"-Unframed) SQFT 425 691 14 Furnish Single Sheet Aluminum Sign (0.080"-Framed) SQFT 25 15 Furnish Single Sheet Aluminum Sign (0.080"-Framed) SQFT 25 16 Metal (Barrier Mounted Sign) LB 320 17 Roadside Sign - One Post EA 2.3 18 Install Sign (Strap and Saddle Bracket Method) EA 1 19 Install Sign Panel on Toll Booth <t< td=""><td>2</td><td>Remove Pavement Marking</td><td>SQFT</td><td>130 196</td><td></td></t<>	2	Remove Pavement Marking	SQFT	130 196	
5 Remove Roadside Sign EA 20 6 Remove Sign From Electrolier EA 1 7 Remove Sign Panel EA 1 8 Relocate Roadside Sign (Wood Post) EA 1 9 Relocate Framed Sign Panel EA 2 10 Replace Sign Panel (Roadside Sign) EA 39 11 Lead Compliance Plan LS 1 12 Furnish Formed Panel Sign (Overhead) SQFT 402 219 13 Furnish Single Sheet Aluminum Sign (0.080"-Unframed) SQFT 492 2691 14 Furnish Single Sheet Aluminum Sign (0.080"-Framed) SQFT 25 15 Furnish Single Sheet Aluminum Sign (0.080"-Framed) SQFT 25 16 Metal (Barrier Mounted Sign) LB 320 17 Roadside Sign - One Post EA 2.3 18 Install Sign (Strap and Saddle Bracket Method) EA 1 19 Install Sign Panel on Toll Booth EA 19 21 Install Roadside Sign Panel on Existing P	3	Remove Thermoplastic Traffic Stripe	LF	8,865 <i>13,998</i>	
6 Remove Sign From Electrolier EA 1 7 Remove Sign Panel EA 1 8 Relocate Roadside Sign (Wood Post) EA 1 9 Relocate Framed Sign Panel EA 2 10 Replace Sign Panel (Roadside Sign) EA 39 11 Lead Compliance Plan LS 1 12 Furnish Formed Panel Sign (Overhead) SQFT 402 219 13 Furnish Formed Panel Sign (Overhead) SQFT 402 219 14 Furnish Single Sheet Aluminum Sign (0.063"-Unframed) SQFT 25 15 Furnish Single Sheet Aluminum Sign (0.080"-Unframed) SQFT 25 15 Furnish Single Sheet Aluminum Sign (0.080"-Framed) SQFT 25 16 Metal (Barrier Mounted Sign) LB 320 17 Roadside Sign - One Post EA 2.3 18 Install Sign (Strap and Saddle Bracket Method) EA 1 19 Install Sign Overlay SQFT 264 270 20 Install Roadside Sign (Lam	4	Remove Pavement Marker	EA	641 916	
7 Remove Sign Panel EA 1 8 Relocate Roadside Sign (Wood Post) EA 1 9 Relocate Framed Sign Panel EA 2 10 Replace Sign Panel (Roadside Sign) EA 39 11 Lead Compliance Plan LS 1 12 Furnish Formed Panel Sign (Overhead) SQFT 402 219 13 Furnish Formed Panel Sign (Overhead) SQFT 402 219 13 Furnish Single Sheet Aluminum Sign (0.063"-Unframed) SQFT 25 15 Furnish Single Sheet Aluminum Sign (0.080"-Unframed) SQFT 25 15 Furnish Single Sheet Aluminum Sign (0.080"-Framed) SQFT 25 16 Metal (Barrier Mounted Sign) LB 320 17 Roadside Sign - One Post EA 2.3 18 Install Sign (Strap and Saddle Bracket Method) EA 1 19 Install Sign Overlay SQFT 264 270 20 Install Roadside Sign Panel on Existing Post EA 34 21 Install	5	Remove Roadside Sign	EA	20	
8 Relocate Roadside Sign (Wood Post) EA 1 9 Relocate Framed Sign Panel EA 2 10 Replace Sign Panel (Roadside Sign) EA 39 11 Lead Compliance Plan LS 1 12 Furnish Formed Panel Sign (Overhead) SQFT 402 219 13 Furnish Single Sheet Aluminum Sign (0.063"-Unframed) SQFT 672 691 14 Furnish Single Sheet Aluminum Sign (0.080"-Unframed) SQFT 25 15 Furnish Single Sheet Aluminum Sign (0.080"-Framed) SQFT 126 16 Metal (Barrier Mounted Sign) LB 320 17 Roadside Sign - One Post EA 2 3 18 Install Sign (Strap and Saddle Bracket Method) EA 1 19 Install Sign Panel on Toll Booth EA 1 19 Install Sign Panel on Existing Post EA 34 21 Install Roadside Sign (Laminated Wood Box Post) - EA 2 22 Two Post EA 2 23 4" Thermop	6	Remove Sign From Electrolier	EA	1	
9 Relocate Framed Sign Panel EA 2 10 Replace Sign Panel (Roadside Sign) EA 39 11 Lead Compliance Plan LS 1 12 Furnish Formed Panel Sign (Overhead) SQFT 402 219 13 Furnish Single Sheet Aluminum Sign (0.080"-Unframed) SQFT 672 691 14 Furnish Single Sheet Aluminum Sign (0.080"-Unframed) SQFT 25 15 Furnish Single Sheet Aluminum Sign (0.080"-Framed) SQFT 126 16 Metal (Barrier Mounted Sign) LB 320 17 Roadside Sign - One Post EA 2 3 18 Install Sign (Strap and Saddle Bracket Method) EA 1 19 Install Sign (Strap and Saddle Bracket Method) EA 1 20 Install Sign Panel on Toll Booth EA 19 21 Install Roadside Sign Panel on Existing Post EA 34 22 Install Roadside Sign (Laminated Wood Box Post) - Town Post EA 2 23 4" Thermoplastic Traffic Stripe (Broken 12-3) LF <t< td=""><td>7</td><td>Remove Sign Panel</td><td>EA</td><td>1</td><td></td></t<>	7	Remove Sign Panel	EA	1	
Replace Sign Panel (Roadside Sign)	8	Relocate Roadside Sign (Wood Post)	EA	1	
Lead Compliance Plan	9	Relocate Framed Sign Panel	EA	2	
12 Furnish Formed Panel Sign (Overhead) SQFT 402 219 13 Furnish Single Sheet Aluminum Sign (0.063"-Unframed) SQFT 672 691 14 Furnish Single Sheet Aluminum Sign (0.080"-Unframed) SQFT 25 15 Furnish Single Sheet Aluminum Sign (0.080"-Framed) SQFT 126 16 Metal (Barrier Mounted Sign) LB 320 17 Roadside Sign - One Post EA 2 3 18 Install Sign (Strap and Saddle Bracket Method) EA 1 19 Install Sign Overlay SQFT 264 270 20 Install Roadside Sign Panel on Toll Booth EA 19 21 Install Roadside Sign (Laminated Wood Box Post) - Two Post EA 2 22 Install Roadside Sign (Laminated Wood Box Post) - Two Post EA 2 23 4" Thermoplastic Traffic Stripe (Broken 36-12) LF 3,085 5,350 24 8" Thermoplastic Traffic Stripe (Broken 12-3) LF 2,267 1,833 26 Pavement Marker (Non-Reflective) EA 253 438 27 Pavement	10	Replace Sign Panel (Roadside Sign)	EA	39	
13 Furnish Single Sheet Aluminum Sign (0.063"-Unframed) SQFT 672 691 14 Furnish Single Sheet Aluminum Sign (0.080"-Unframed) SQFT 25 15 Furnish Single Sheet Aluminum Sign (0.080"-Framed) SQFT 126 16 Metal (Barrier Mounted Sign) LB 320 17 Roadside Sign - One Post EA 2 3 18 Install Sign (Strap and Saddle Bracket Method) EA 1 19 Install Sign Overlay SQFT 264 270 20 Install Sign Panel on Toll Booth EA 19 21 Install Roadside Sign Panel on Existing Post EA 34 22 Install Roadside Sign (Laminated Wood Box Post) - Two Post EA 2 23 4" Thermoplastic Traffic Stripe (Broken 36-12) LF 3,085 5,350 24 8" Thermoplastic Traffic Stripe (Broken 12-3) LF 2,267 1,833 26 Pavement Marker (Non-Reflective) EA 253 438 27 Pavement Marker (Retroreflective) EA 368 471 28 Mobilization LS 1 29 Remove Painted Traffic Stripe LF 3,154 31 Thermoplastic Tavific Stripe (2-Coat) LF 341 341 Tavific Stripe (2-Coat) LF 341 341 Termoplastic Stripe (2-Coat) LF 341 341 Termoplastic Stripe (2-Coat) LF 341 341 Termoplastic Traffic Stripe (2-Coat) LF 341 342 Termoplastic Traffic Stripe (2-Coat) LF 341 343 Termoplastic Traffic Stripe (2-Coat) LF 341 344 Traffic Stripe (2-Coat) LF 341 345 Termoplastic Traffic Stripe (2-Coat) LF 341 346 Termoplastic Traffic Stripe (2-Coat) LF 341 347 Termo	11	Lead Compliance Plan	LS	1	
14 Furnish Single Sheet Aluminum Sign (0.080"-Unframed) SQFT 25 15 Furnish Single Sheet Aluminum Sign (0.080"-Framed) SQFT 126 16 Metal (Barrier Mounted Sign) LB 320 17 Roadside Sign - One Post EA 23 18 Install Sign (Strap and Saddle Bracket Method) EA 1 19 Install Sign Overlay SQFT 264 270 20 Install Sign Panel on Toll Booth EA 19 21 Install Roadside Sign Panel on Existing Post EA 34 22 Install Roadside Sign (Laminated Wood Box Post) - Two Post EA 2 23 4" Thermoplastic Traffic Stripe (Broken 36-12) LF 3,085 5,350 24 8" Thermoplastic Traffic Stripe LF 3,042 3,260 25 8" Thermoplastic Traffic Stripe (Broken 12-3) LF 2,267 1,833 26 Pavement Marker (Non-Reflective) EA 253 438 27 Pavement Marker (Retroreflective) EA 368 471 28 Mobilization LS 1 <td>12</td> <td>Furnish Formed Panel Sign (Overhead)</td> <td>SQFT</td> <td>402 219</td> <td></td>	12	Furnish Formed Panel Sign (Overhead)	SQFT	402 219	
15 Furnish Single Sheet Aluminum Sign (0.080"-Framed) SQFT 126 16 Metal (Barrier Mounted Sign) LB 320 17 Roadside Sign - One Post EA 23 18 Install Sign (Strap and Saddle Bracket Method) EA 1 19 Install Sign Overlay SQFT 264 270 20 Install Sign Panel on Toll Booth EA 19 21 Install Roadside Sign Panel on Existing Post EA 34 22 Install Roadside Sign (Laminated Wood Box Post) - Two Post EA 2 23 4" Thermoplastic Traffic Stripe (Broken 36-12) LF 3,085 5,350 24 8" Thermoplastic Traffic Stripe LF 3,042 3,260 25 8" Thermoplastic Traffic Stripe (Broken 12-3) LF 2,267 1,833 26 Pavement Marker (Non-Reflective) EA 253 438 27 Pavement Marker (Retroreflective) EA 368 471 28 Mobilization LS 1 29 Remove Painted Traffic Stripe LF 3,154	13	Furnish Single Sheet Aluminum Sign (0.063"-Unframed)	SQFT	672 691	
16 Metal (Barrier Mounted Sign) LB 320 17 Roadside Sign - One Post EA 2 3 18 Install Sign (Strap and Saddle Bracket Method) EA 1 19 Install Sign Overlay SQFT 264 270 20 Install Sign Panel on Toll Booth EA 19 21 Install Roadside Sign Panel on Existing Post EA 34 22 Install Roadside Sign (Laminated Wood Box Post) - Two Post EA 2 23 4" Thermoplastic Traffic Stripe (Broken 36-12) LF 3,085 5,350 24 8" Thermoplastic Traffic Stripe LF 3,042 3,260 25 8" Thermoplastic Traffic Stripe (Broken 12-3) LF 2,267 1,833 26 Pavement Marker (Non-Reflective) EA 253 438 27 Pavement Marker (Retroreflective) EA 368 471 28 Mobilization LS 1 29 Remove Painted Traffic Stripe LF 3,154 30 4" Thermoplastic Pavement Marking SQFT 920 32 <td>14</td> <td>Furnish Single Sheet Aluminum Sign (0.080"-Unframed)</td> <td>SQFT</td> <td>25</td> <td></td>	14	Furnish Single Sheet Aluminum Sign (0.080"-Unframed)	SQFT	25	
17 Roadside Sign - One Post EA 2 3 18 Install Sign (Strap and Saddle Bracket Method) EA 1 19 Install Sign Overlay SQFT 264 270 20 Install Sign Panel on Toll Booth EA 19 21 Install Roadside Sign Panel on Existing Post EA 34 22 Install Roadside Sign (Laminated Wood Box Post) - Two Post EA 2 23 4" Thermoplastic Traffic Stripe (Broken 36-12) LF 3,085 5,350 24 8" Thermoplastic Traffic Stripe LF 3,042 3,260 25 8" Thermoplastic Traffic Stripe (Broken 12-3) LF 2,267 1,833 26 Pavement Marker (Non-Reflective) EA 253 438 27 Pavement Marker (Retroreflective) EA 368 471 28 Mobilization LS 1 29 Remove Painted Traffic Stripe LF 3,154 30 4" Thermoplastic Pavement Marking SQFT 920 32 Paint Traffic Stripe (2-Coat) LF 341	15	Furnish Single Sheet Aluminum Sign (0.080"-Framed)	SQFT	126	
18Install Sign (Strap and Saddle Bracket Method)EA119Install Sign OverlaySQFT264 27020Install Sign Panel on Toll BoothEA1921Install Roadside Sign Panel on Existing PostEA3422Install Roadside Sign (Laminated Wood Box Post) - Two PostEA2234" Thermoplastic Traffic Stripe (Broken 36-12)LF3,085 5,350248" Thermoplastic Traffic Stripe (Broken 12-3)LF2,267 1,83326Pavement Marker (Non-Reflective)EA253 43827Pavement Marker (Retroreflective)EA368 47128MobilizationLS129Remove Painted Traffic StripeLF255304" Thermoplastic Traffic StripeLF3,15431Thermoplastic Pavement MarkingSQFT92032Paint Traffic Stripe (2-Coat)LF341	16	Metal (Barrier Mounted Sign)	LB	320	
19	17	Roadside Sign - One Post	EA	23	
Install Sign Panel on Toll Booth EA 19	18	Install Sign (Strap and Saddle Bracket Method)	EA	1	
21 Install Roadside Sign Panel on Existing Post EA 34 22 Install Roadside Sign (Laminated Wood Box Post) - Two Post EA 2 23 4" Thermoplastic Traffic Stripe (Broken 36-12) LF 3,085 5,350 24 8" Thermoplastic Traffic Stripe LF 3,042 3,260 25 8" Thermoplastic Traffic Stripe (Broken 12-3) LF 2,267 1,833 26 Pavement Marker (Non-Reflective) EA 253 438 27 Pavement Marker (Retroreflective) EA 368 471 28 Mobilization LS 1 29 Remove Painted Traffic Stripe LF 255 30 4" Thermoplastic Traffic Stripe LF 3,154 31 Thermoplastic Pavement Marking SQFT 920 32 Paint Traffic Stripe (2-Coat) LF 341	19	Install Sign Overlay	SQFT	264 270	
22 Install Roadside Sign (Laminated Wood Box Post) -	20	Install Sign Panel on Toll Booth	EA	19	
22 Two Post EA 2 23 4" Thermoplastic Traffic Stripe (Broken 36-12) LF 3,085 5,350 24 8" Thermoplastic Traffic Stripe LF 3,042 3,260 25 8" Thermoplastic Traffic Stripe (Broken 12-3) LF 2,267 1,833 26 Pavement Marker (Non-Reflective) EA 253 438 27 Pavement Marker (Retroreflective) EA 368 471 28 Mobilization LS 1 29 Remove Painted Traffic Stripe LF 255 30 4" Thermoplastic Traffic Stripe LF 3,154 31 Thermoplastic Pavement Marking SQFT 920 32 Paint Traffic Stripe (2-Coat) LF 341	21	Install Roadside Sign Panel on Existing Post	EA	34	
24 8" Thermoplastic Traffic Stripe LF 3,042 3,260 25 8" Thermoplastic Traffic Stripe (Broken 12-3) LF 2,267 1,833 26 Pavement Marker (Non-Reflective) EA 253 438 27 Pavement Marker (Retroreflective) EA 368 471 28 Mobilization LS 1 29 Remove Painted Traffic Stripe LF 255 30 4" Thermoplastic Traffic Stripe LF 3,154 31 Thermoplastic Pavement Marking SQFT 920 32 Paint Traffic Stripe (2-Coat) LF 341	22		EA	2	
25 8" Thermoplastic Traffic Stripe (Broken 12-3) LF 2,267 1,833 26 Pavement Marker (Non-Reflective) EA 253 438 27 Pavement Marker (Retroreflective) EA 368 471 28 Mobilization LS 1 29 Remove Painted Traffic Stripe LF 255 30 4" Thermoplastic Traffic Stripe LF 3,154 31 Thermoplastic Pavement Marking SQFT 920 32 Paint Traffic Stripe (2-Coat) LF 341	23	4" Thermoplastic Traffic Stripe (Broken 36-12)	LF	3,085 5,350	
26Pavement Marker (Non-Reflective)EA253 43827Pavement Marker (Retroreflective)EA368 47128MobilizationLS129Remove Painted Traffic StripeLF255304" Thermoplastic Traffic StripeLF3,15431Thermoplastic Pavement MarkingSQFT92032Paint Traffic Stripe (2-Coat)LF341	24	8" Thermoplastic Traffic Stripe	LF	3,042 <i>3,260</i>	
27Pavement Marker (Retroreflective)EA368 47128MobilizationLS129Remove Painted Traffic StripeLF255304" Thermoplastic Traffic StripeLF3,15431Thermoplastic Pavement MarkingSQFT92032Paint Traffic Stripe (2-Coat)LF341	25	8" Thermoplastic Traffic Stripe (Broken 12-3)	LF	2,267 1,833	
28MobilizationLS129Remove Painted Traffic StripeLF255304" Thermoplastic Traffic StripeLF3,15431Thermoplastic Pavement MarkingSQFT92032Paint Traffic Stripe (2-Coat)LF341	26	Pavement Marker (Non-Reflective)	EA	253 438	
29Remove Painted Traffic StripeLF255304" Thermoplastic Traffic StripeLF3,15431Thermoplastic Pavement MarkingSQFT92032Paint Traffic Stripe (2-Coat)LF341	27	Pavement Marker (Retroreflective)	EA	368 471	
30 4" Thermoplastic Traffic Stripe LF 3,154 31 Thermoplastic Pavement Marking SQFT 920 32 Paint Traffic Stripe (2-Coat) LF 341	28	Mobilization	LS	1	
31 Thermoplastic Pavement Marking SQFT 920 32 Paint Traffic Stripe (2-Coat) LF 341	29	Remove Painted Traffic Stripe	LF	255	
32 Paint Traffic Stripe (2-Coat) LF 341	30	4" Thermoplastic Traffic Stripe	LF	3,154	
	31	Thermoplastic Pavement Marking	SQFT	920	
TOTAL COST – PROEJCT 1	32	Paint Traffic Stripe (2-Coat)	LF	341	
l		TOTA	AL COST – P	ROEJCT 1	

ATTACHMENT 1 (continued) SCHEDULE OF QUANTITIES AND PRICES (revised)

The prices quoted below include all applicable taxes, fees, permits, delivery and other charges as

required.

Item Description	Unit of Measure	Estimated Quantity	Item Price	Project Total
Traffic Control System	LS	1		
Remove Roadside Sign	EA	-8 10		
Lead Compliance Plan	LS	1		
Furnish Formed Panel Sign (Overhead)	SQFT	490		
Furnish Single Sheet Aluminum Sign (0.080"-Framed)	SQFT	338 275		
Metal (Rail Mounted Sign)	LB	680		
Roadside Sign - Two Post	EA	8		
Install Sign (Strap and Saddle Bracket Method)	EA	2		
Mobilization	LS	1		
TOTA	AL COST – P	ROJECT 2		
TOTAL CONTRACT PRICE	(PROJECTS	3 1 AND 2)		
	Traffic Control System Remove Roadside Sign Lead Compliance Plan Furnish Formed Panel Sign (Overhead) Furnish Single Sheet Aluminum Sign (0.080"-Framed) Metal (Rail Mounted Sign) Roadside Sign - Two Post Install Sign (Strap and Saddle Bracket Method) Mobilization TOTA	Traffic Control System Remove Roadside Sign LS Lead Compliance Plan LS Furnish Formed Panel Sign (Overhead) Furnish Single Sheet Aluminum Sign (0.080"-Framed) Metal (Rail Mounted Sign) Roadside Sign - Two Post Install Sign (Strap and Saddle Bracket Method) Measure LS EA LS TOTAL COST - P	Traffic Control System Remove Roadside Sign Lead Compliance Plan Furnish Formed Panel Sign (Overhead) Furnish Single Sheet Aluminum Sign (0.080"-Framed) Measure Quantity LS 1 LS 1 SQFT 490 Furnish Single Sheet Aluminum Sign (0.080"-Framed) Measure EA 8 Install Sign (Strap and Saddle Bracket Method) EA 2	Traffic Control System Remove Roadside Sign Lead Compliance Plan Furnish Formed Panel Sign (Overhead) Furnish Single Sheet Aluminum Sign (0.080"-Framed) Measure Remove Roadside Sign LS 1 LS 1 Furnish Formed Panel Sign (Overhead) Furnish Single Sheet Aluminum Sign (0.080"-Framed) Measure Roadside Sign EA 9 9 9 9 9 1 1 1 1 1 1 1 1

Note: No Bidder may withdraw its bid for a period of 120 calendars days after bid opening


ATTACHMENT 2


Replace Sign Design A with Sign Design B, in the following 38 plan sheet locations:


Bridge	Sheet No.	Sign No.	Nos. of Signs
Antioch Bridge	S-1 (SD-1)	5	2
Andoch Bridge	S-4 (SD-1)	3	2
Benicia-Martinez Bridge	S-3 (SD-1)	1	2
Defincta-Martiflez Bridge	S-8 (SD-1)	1	2
	S-4 (SD-1)	1	
Dumbarton Bridge	S-6 (SD-1)	1	6
	S-7 (SD-1)	3, 4, 5, 6	
	S-1 (SD-1)	1, 2	
	S-2 (SD-1)	1, 2, 3	
	S-3 (SD-1)	1, 2, 3, 4, 5, 6, 7, 9	
San Francisco-Oakland Bay Bridge	S-4 (SD-1)	1, 2, 3	23
	S-5 (SD-1)	1, 2, 3	
	S-6 (SD-1)	1, 2, 3	
	S-7 (SD-1)	1	
	S-1 (SD-1)	1, 2	
San Mateo-Hayward Bridge	S-4 (SD-1)	1	5
San Maco Hay ward Bridge	S-7 (SD-1)	1	3
	S-11 (SD-1)	3	


ATTACHMENT 3

REVISED PLAN SHEETS

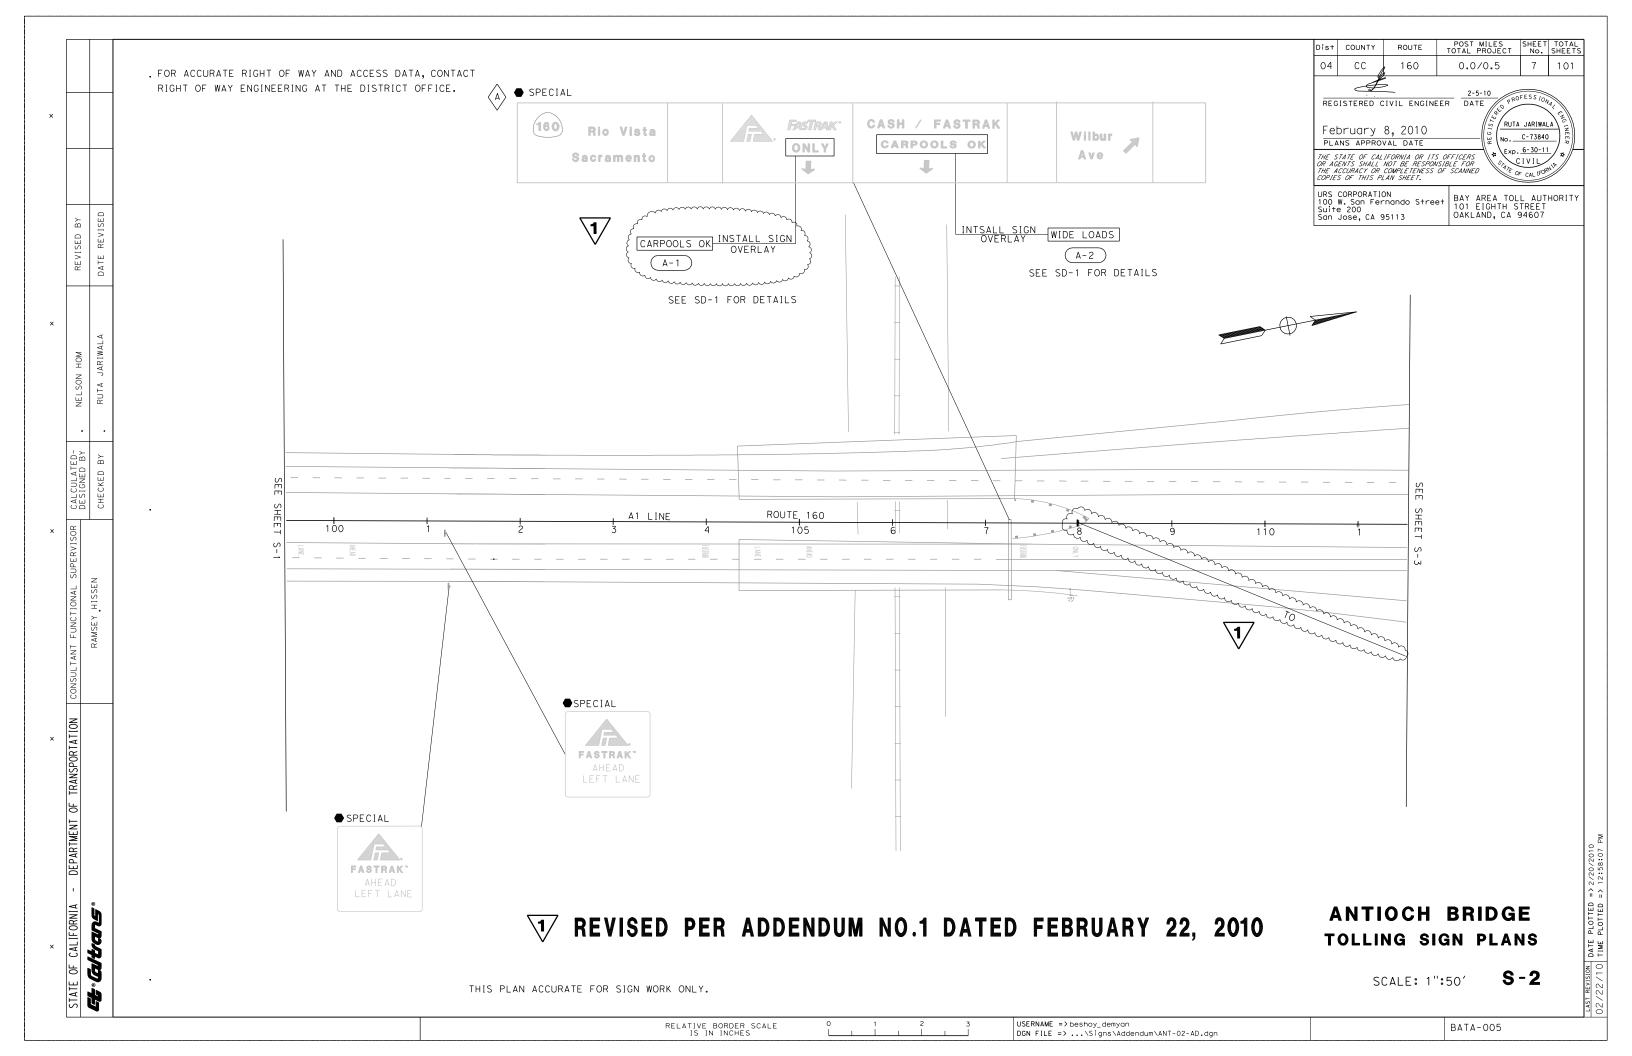

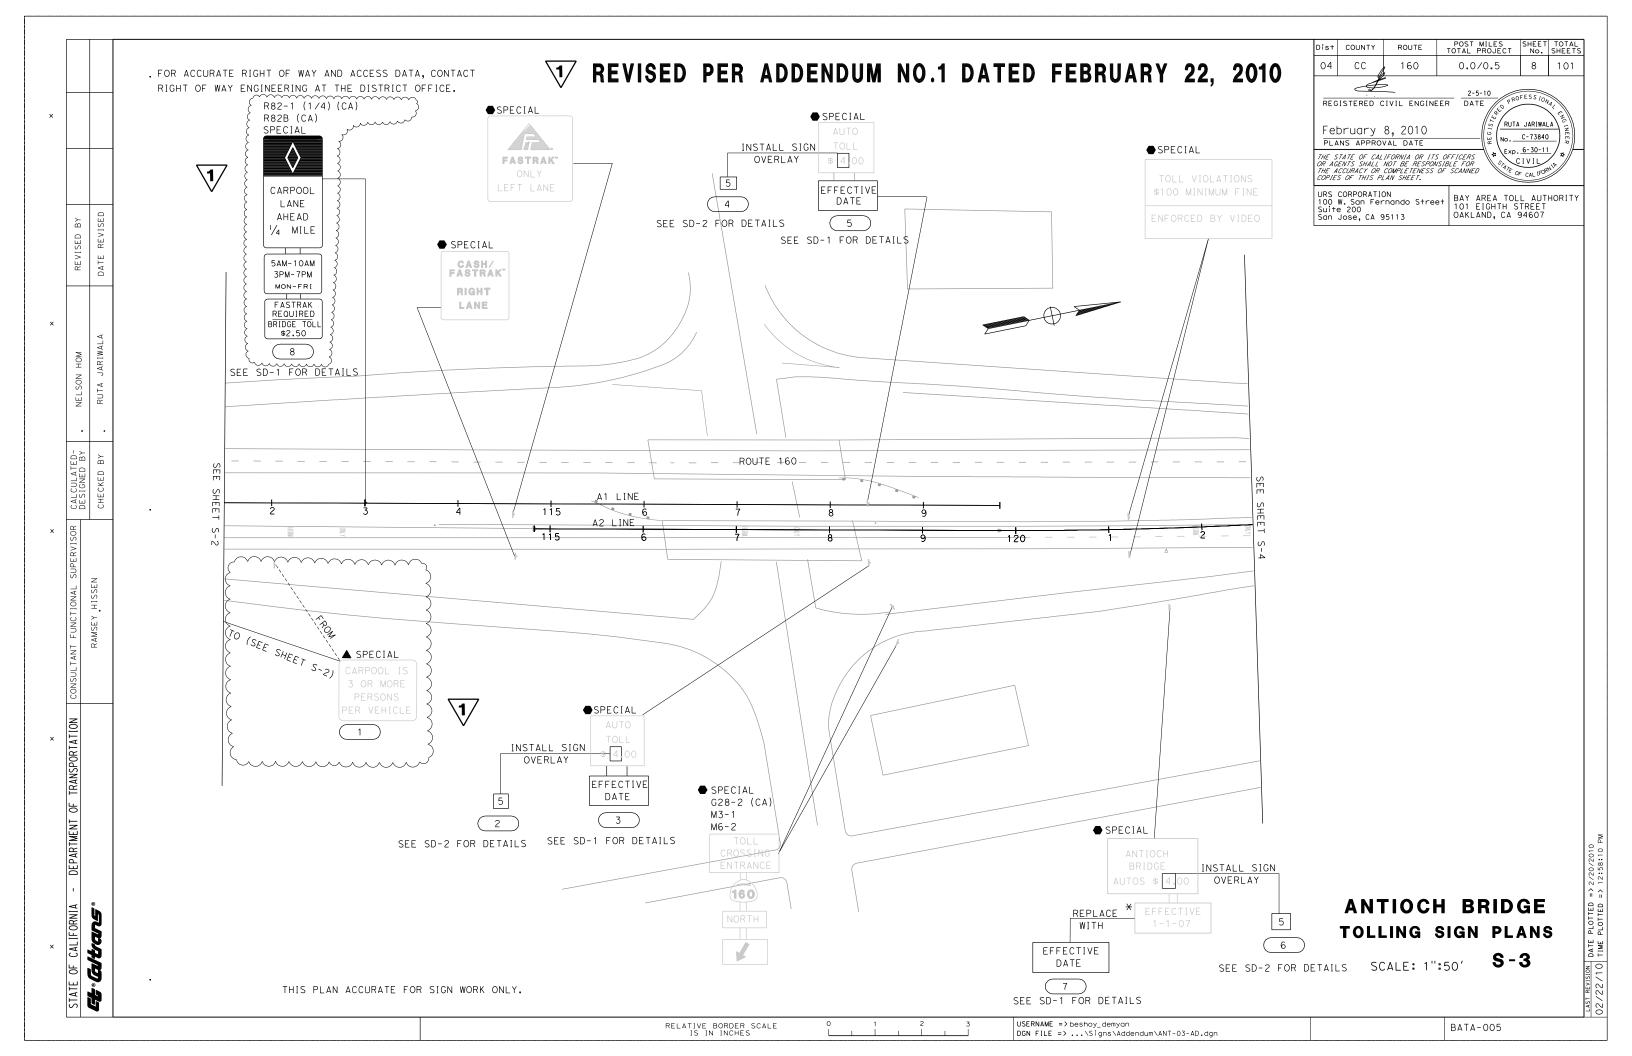

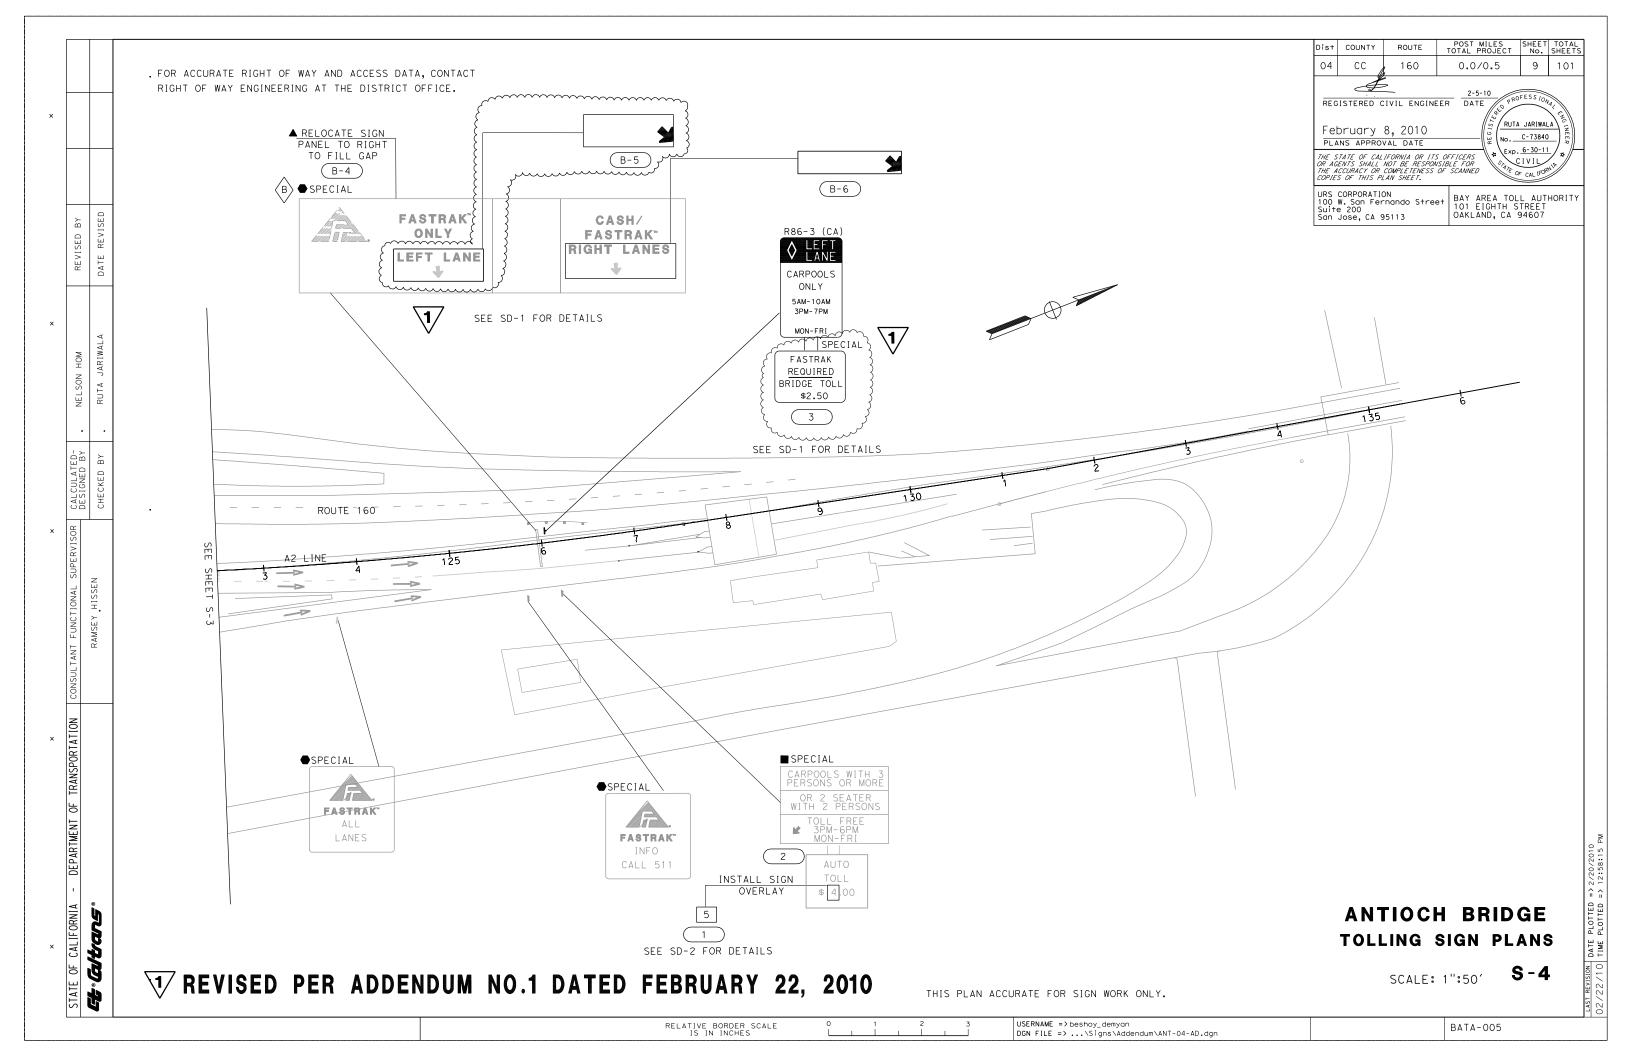

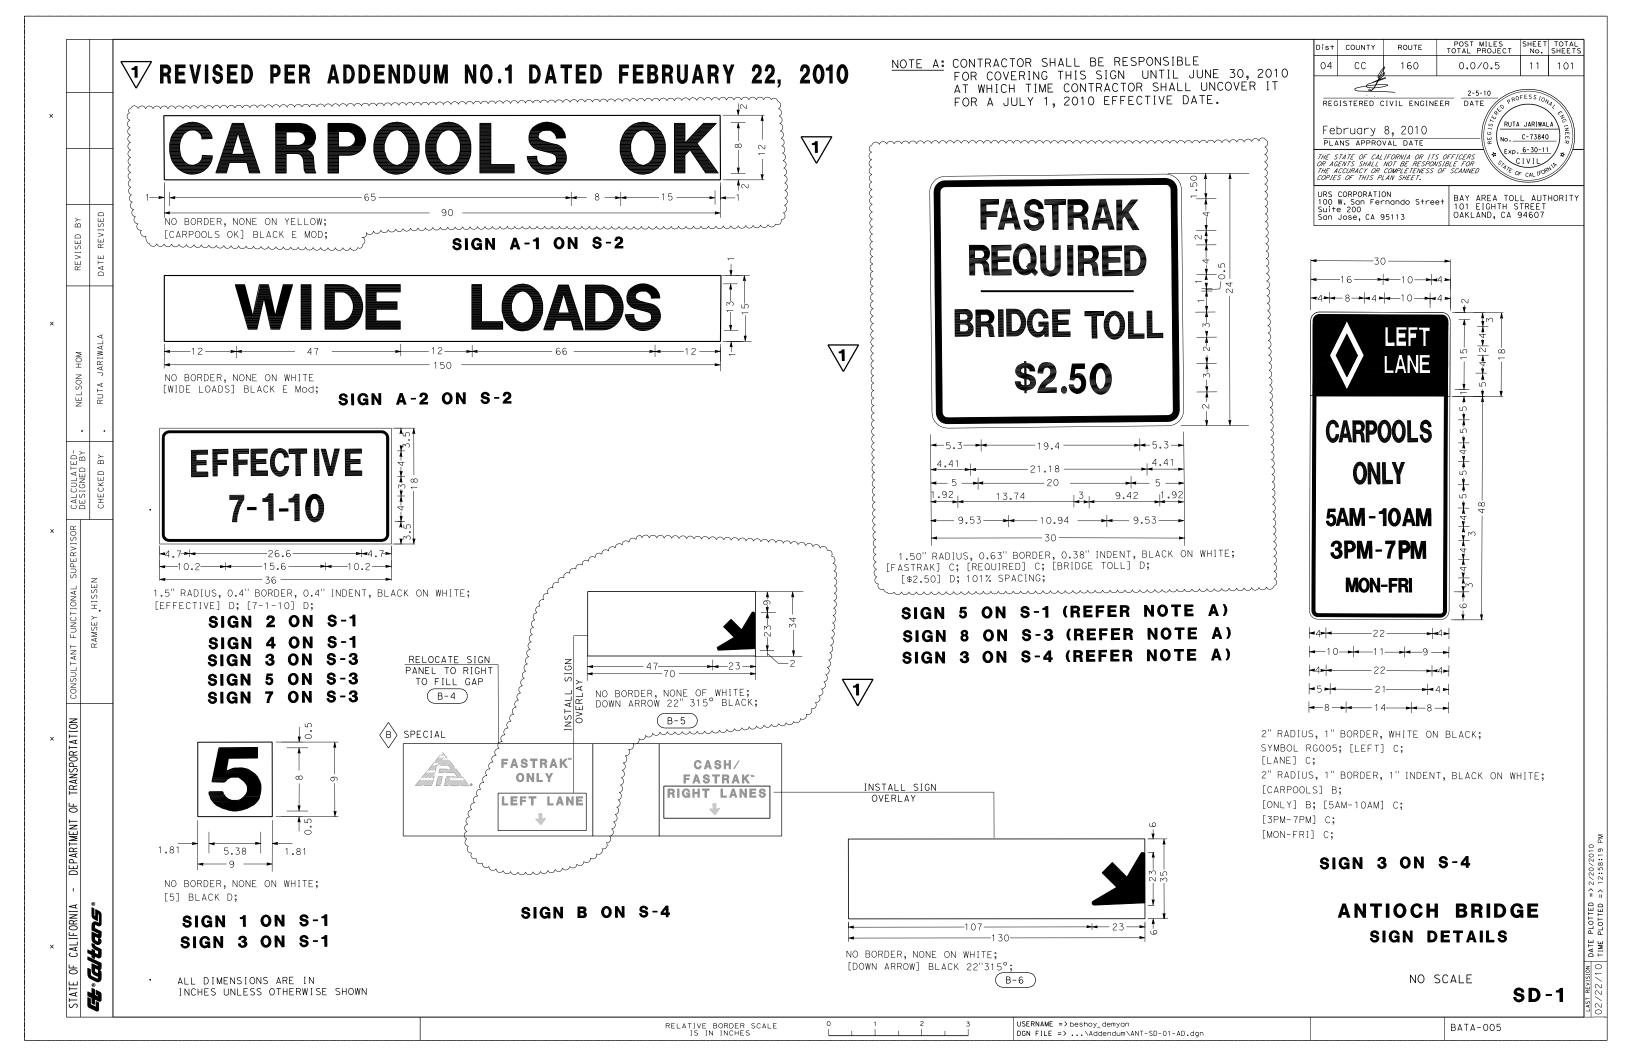

ANTIOCH BRIDGE SIGN QUANTITIES

NO SCALE

SQ-1

RELATIVE BORDER SCALE IS IN INCHES

USERNAME => beshoy_demyan
DGN FILE => ...\Signs\Addendum\ANT-SO-1-AD.dgn

G/trans

(N) = NOT A SEPARATE PAY ITEM. FOR INFORMATION ONLY.

TREVISED PER ADDENDUM NO.1 DATED FEBRUARY 22, 2010

BATA-005

POST MILES TOTAL PROJECT

0.0/0.5

13

RUTA JARIWALA

No. C-73840

Exp. 6-30-11

BAY AREA TOLL AUTHORITY 101 EIGHTH STREET OAKLAND, CA 94607

CIVIL

ROUTE

160

СС

£

Dist COUNTY 04 CC 160 0.0/0.5 14 £ REGISTERED CIVIL ENGINEER DATE RUTA JARIWALA February 8, 2010
PLANS APPROVAL DATE No. C-73840 Exp. 6-30-11 THE STATE OF CALIFORNIA OR ITS OFFICERS OR AGENTS SHALL NOT BE RESPONSIBLE FOR THE ACCURACY OR COMPLETENESS OF SCANNED COPIES OF THIS PLAN SHEET. URS CORPORATION 100 W. San Fernando Street Suite 200 San Jose, CA 95113 BAY AREA TOLL AUTHORITY 101 EIGHTH STREET OAKLAND, CA 94607

SIGN PANEL SUMMARY

								SIZE	FACING MATERIA	L		SIGN PANEL SUBSTRATE MATERIAL	OVERLAY	
	SHEET	SIGN	SIGN	PANEL SIZE	AREA	SINGLE	BACKGR	OUND	LEGEN	ND.	PROTECTIVE FILM	ROADSIDE	(SINGLE SHEET OVERLAY FLAT/ NO RADI/	REMARKS
	No.	No.	CODE	SIZE		FACED	SHEETING COLOR	RETRORE - FLECTIVE	SHEETING COLOR	RETRORE- FLECTIVE	PREMIUM	SINGLE SHEET UNFRAMED ALUMINUM (0.063")	NO BORDER)	T.E.W.T.T.
				FT × FT	SQFT			ASTM TYPE		ASTM TYPE		SQFT	SQFT	
	S-1	1	SPECIAL	0.75 × 0.75	0.56	×	WHITE	III	BLACK	PLAIN	×		0.56	
	S-1	2	SPECIAL	3.00 × 1.50	4.50	×	WHITE	III	BLACK	PLAIN	×	4.50		
	S-1	3	SPECIAL	0.75 × 0.75	0.56	×	WHITE	III	BLACK	PLAIN	×		0.56	
	S-1	4	SPECIAL	3.00 × 1.50	4.50	×	WHITE	III	BLACK	PLAIN	×	4.50		
			R82-1 (CA)	2.50 × 5.00	12.50	×	WHITE/BLACK	III/PLAIN	WHITE/BLACK	III/PLAIN	×	12.50		
	S-1	5	R82B (CA)	2.50 × 2.00	5.00	×	WHITE	III	BLACK	PLAIN	×	5.00		
			SPECIAL	2.50 x 2.00	5.00	×	WHITE	111	BLACK	PLAIN	×	5.00		
1/	{ S-2	A - 1	SPECIAL	7.50 × 1.00	7.50	×	WHITE	III	BLACK	PLAIN	×		7.50	
v .[S-2	A-2	SPECIAL	12.50 x 1.25	15.63	×	WHITE	III	BLACK	PLAIN	×		15.63	
	S-3	2	SPECIAL	1.08 × 1.08	1.17	×	WHITE	III	BLACK	PLAIN	×		1.17	
	S-3	3	SPECIAL	3.00 × 1.50	4.50	×	WHITE	III	BLACK	PLAIN	×	4.50		
	S-3	4	SPECIAL	1.08 × 1.08	1.17	×	WHITE	III	BLACK	PLAIN	×		1.17	
	S-3	5	SPECIAL	3.00 × 1.50	4.50	×	WHITE	III	BLACK	PLAIN	×	4.50		
	S-3	6	SPECIAL	0.92 × 0.92	0.85	×	WHITE	III	BLACK	PLAIN	×		0.85	
	~~~~~~~~~~~~~~~~~~~~~~~~~~~~~~~~~~~~~~	7	SPECIAL	3.00 × 1.50	4.50	××	WHITE		BLACK	PLAIN		4.50		
{	*******		R82-1 (1/4) (CA)	2.50 × 5.00	12.50	×	WHITE/BLACK	III/PLAIN	WHITE/BLACK	III/PLAIN	×	12.50	***************************************	······
1/ {	S-3	8	R82B (CA)	2.50 × 2.00	5.00	×	WHITE	III	BLACK	PLAIN	×	5.00		
V .{ [			SPECIAL	2.50 × 2.00	5.00	×	WHITE	III	BLACK	PLAIN	×	5.00		
- 4	S-4	4	SPECIAL	1.08 × 1.08	1.17	×	WHITE	III	BLACK	PLAIN	×		1.17	
			R86-3 (CA)	2.50 × 5.50	13.75	×	WHITE/BLACK	III/PLAIN	WHITE/BLACK	III/PLAIN	×	13.75		
	S-4	3	SPECIAL	2.50 × 2.00	~5.00~	~~~~	WHITE		BLACK	PLAIN	~~~~~~~~~~~~~~~~~~~~~~~~~~~~~~~~~~~~~~	5.00		~~~
1/	{ S-4	B-5	SPECIAL	5.83 × 2.83	16.52	×	WHITE	III	BLACK	PLAIN	×		16.52	}
V	S-4	B-6	SPECIAL	10.83 x 2.91	31.51	××××	WHITE		BLACK	PLAIN			31.51	
1	<del>S-4</del>	B-7	SPECIAL	2.50 x 1.67	4.17	×	WHITE	III	BLACK	PLAIN	×	4.17		<del>- }</del>
<b>V</b>	<del>S-4</del>	B-8	SPECIAL	2.50 × 1.67	4.17	×	WHITE	HH	_	_	×		4.17	- }
	S-5	1	SPECIAL	0.83 × 0.25	0.21	×	WHITE	III	BLACK	PLAIN	×		3 × 0.21 = 0.63	TOTAL OF 3 SIGNS
	S-5	2	SPECIAL	1.00 × 0.75	0.75	×	WHITE	III	BLACK	PLAIN	×		3 × 0.75 = 2.25	TOTAL OF 3 SIGNS
Ī	S-5	3	SPECIAL	1.75 × 0.17	0.30	×	WHITE	III	BLACK	PLAIN	×	~~~	3 × 0.30 = 0.90	TOTAL OF 3 SIGNS
	TOTA	Ĺ										{86.25}	{80.42}	

Ge Culture

TREVISED PER ADDENDUM NO.1 DATED FEBRUARY 22, 2010


RELATIVE BORDER SCALE
IS IN INCHES

**ANTIOCH BRIDGE** SIGN QUANTITIES

NO SCALE

USERNAME => beshoy_demyan
DGN FILE => ...\Addendum\ANT-SQ-2.-AD.dgn

**SQ-2** 

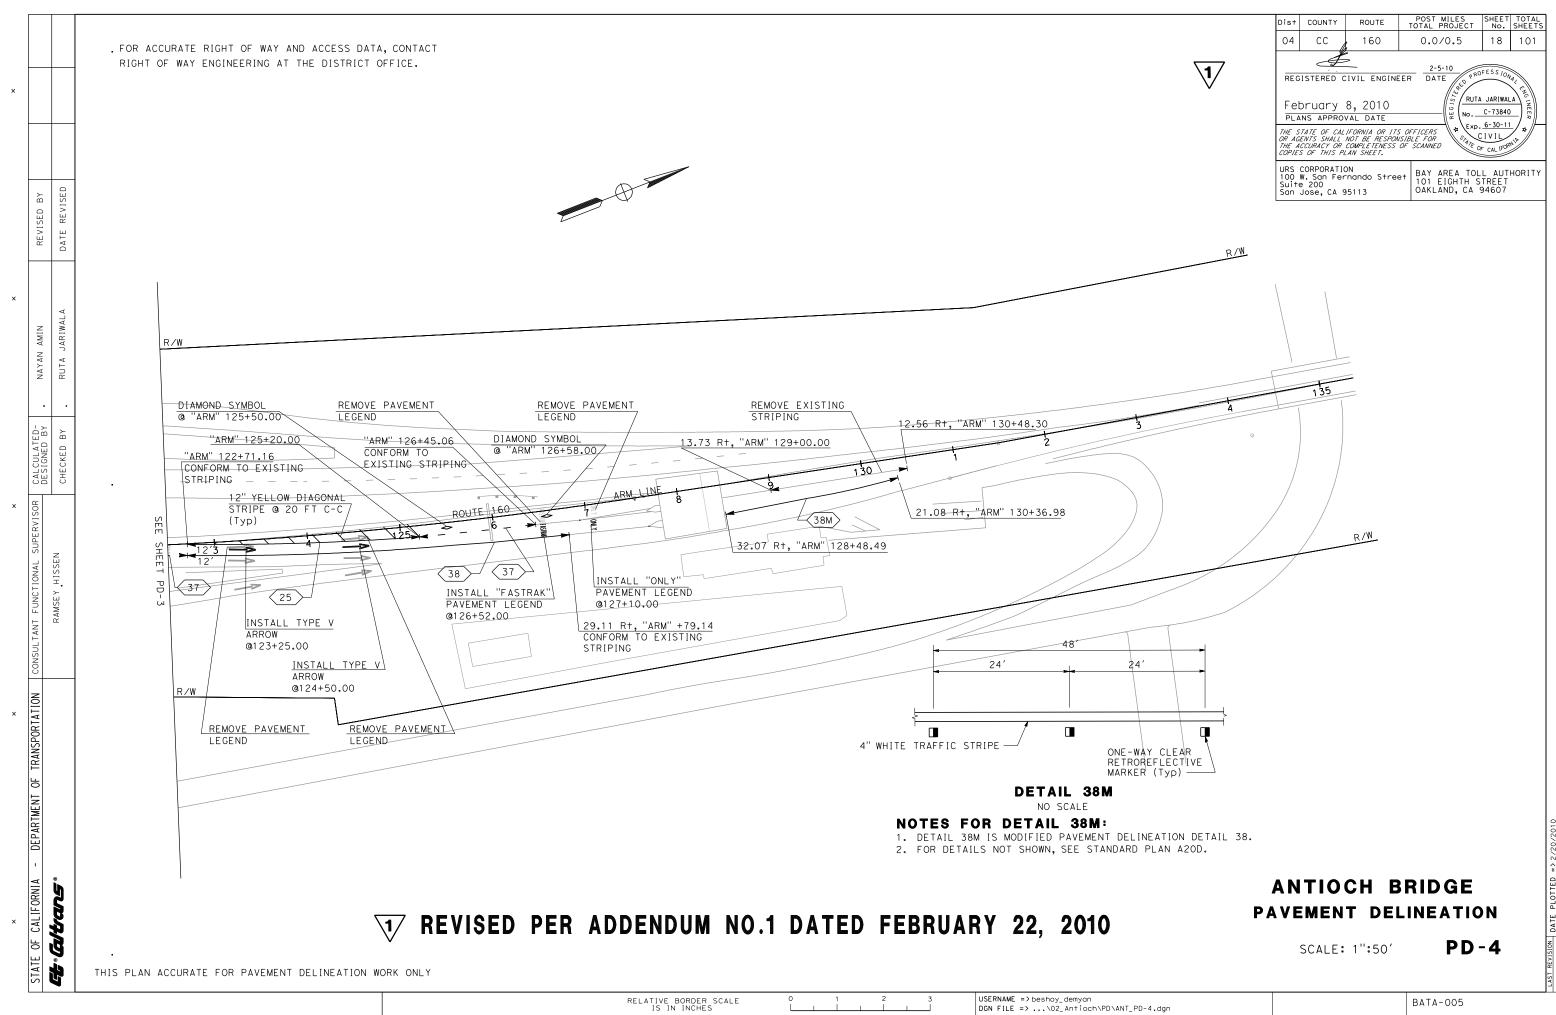

Dist	COUNTY	ROUTE	POST MILES TOTAL PROJECT	SHEET No.	TOTA SHEET
04	cc	160	0.0/0.5	19	101
	4	>			

REGISTERED CIVIL ENGINEER DATE

February 8, 2010
PLANS APPROVAL DATE

THE STATE OF CALIFORNIA OR ITS OFFICERS OR AGENTS SHALL NOT BE RESPONSIBLE FOR THE ACCURACY OR COMPLETENESS OF SCANNED COPIES OF THIS PLAN SHEET.

URS CORPORATION 100 W. San Fernando Street Suite 200 San Jose, CA 95113

BAY AREA TOLL AUTHORITY 101 EIGHTH STREET OAKLAND, CA 94607

RUTA JARIWALA

No. C-73840 Exp. 6-30-11

### PAVEMENT DELINEATION QUANTITIES

					PAVE	MENT MA	RKER	THER	MOPLAS	TIC TRAFF	IC STRIPE	PAVEMENT	Γ MARKING		REMOVE	
								ID		_		C	PAINT		REMOVE.	
SHEET		TION		СТН	RETRO	DREFLECT	IVE	SOL	SOLID	/HITE 12-3	HITE	PLAST	12 in YELLOW	THERMOPLASTIC TRAFFIC	PAVEMENT MARKER	PAVEMENT MARKING
No.	STATION LIMITS	OCA	DETAIL NO. OR PAVEMENT MARKING	LEN	TYPE	TYPE	TYPE	in LLOW	E	in (W	in W LID	RMOP	DIAGONAL STRIPE	STRIPE	MARKER	WANTINO
					C	G	H	4 i YEL	4 W	8 BRO	8 ; SOL	THE	SIMIFE	WHITE YELLOW	ALL TYPES	ALL TYPES
				LF	EΑ	EΑ	EΑ	LF	LF	LF	LF	SQFT	SQFT	LF LF	EA	SQFT
PD-3	"ARM" 120+12.00 TO 122+50.00 NB	R+	37	238	6	12				238				238	18	
PD-4	"ARM" 122+50.00 TO 122+71.16 NB	R+	37	21	2					21				21	2	
	"ARM" 122+71.16 TO 126+79.14 NB	R+	38	408		18					408			408	18	
	"ARM" 122+71.16 TO 125+20.00 NB	R+	25	249			6	249						249	6	
	"ARM" 128+48.49 TO 130+36.98 NB	R†	38M	188		9			188					188	9	
	"ARM" 125+20.00 TO 126+45.06 NB	R+	37	125	8	3				125				125	11	
	"ARM" 126+52.00 TO 127+10.00 NB	R+	"FASTRAK ONLY"									65				65
	"ARM" 122+71.16 TO 125+20.00 NB		YELLOW DIAGONAL										110			
	"ARM" 129+00.00 TO 130+48.30 NB	R+		148										148		
	"ARM" 125+50.00 NB	R+	DIAMOND SYMBOL									11				
	"ARM" 126+58.00 NB	R+	DIAMOND SYMBOL									11				
	"ARM" 123+25.00 NB	R+	TYPE "V" ARROW									33				33
	"ARM" 124+50.00 NB	R+	TYPE "V" ARROW									33				33
	TOTAL				16	42	6	249	188	384	408	153	110	1129 249	65	1 3 1


**ANTIOCH BRIDGE** PAVEMENT DELINEATION QUANTITIES


Et Cutrans


TREVISED PER ADDENDUM NO.1 DATED FEBRUARY 22, 2010

PDQ-1

USERNAME => beshoy_demyan
DGN FILE => ...\02_Antioch\PD\ANT-PD0-1.dgn

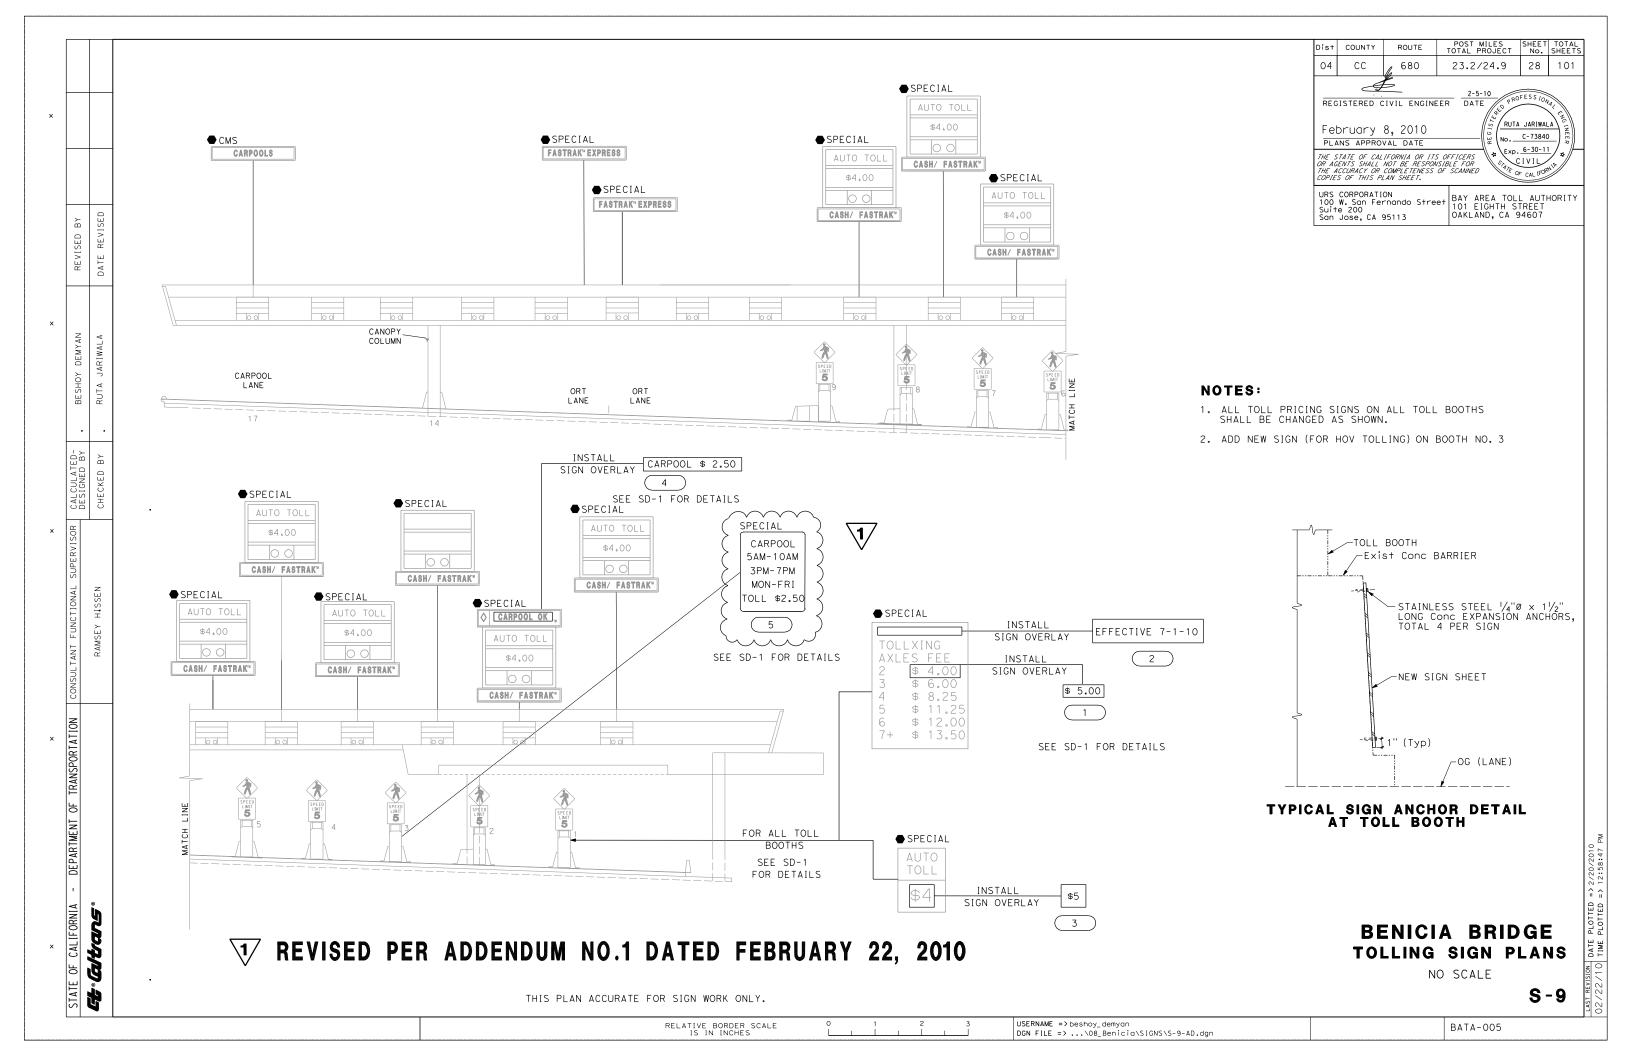

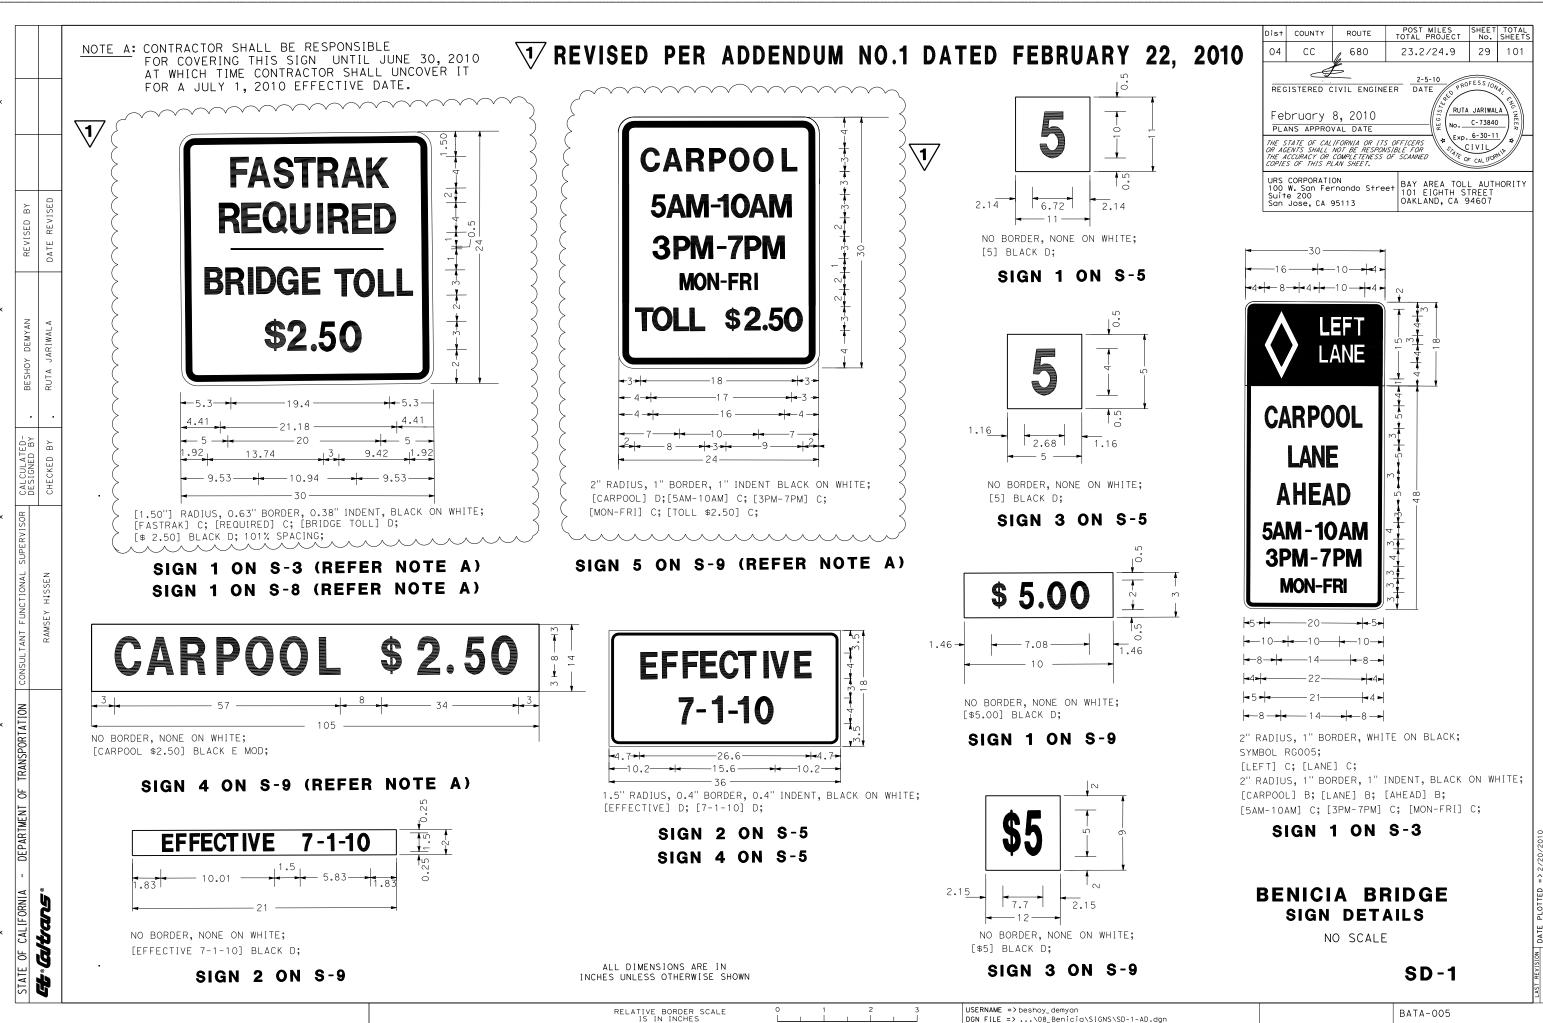

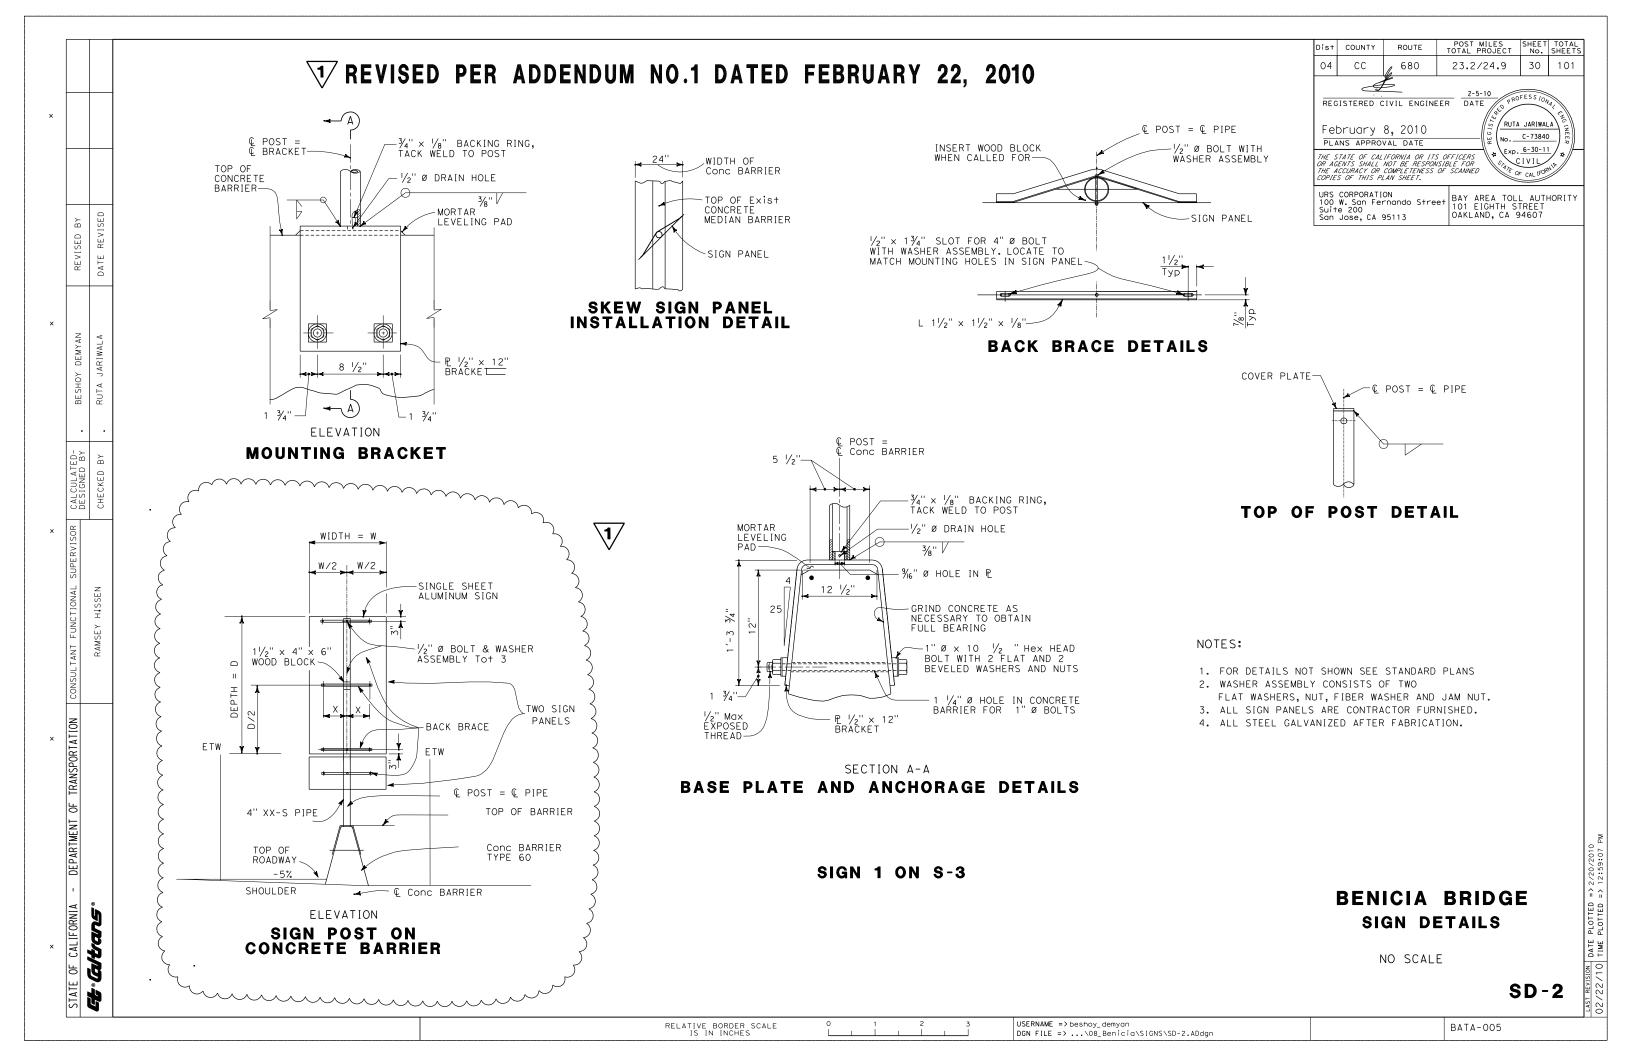

POST MILES SHEET TOTAL TOTAL PROJECT No. SHEETS Dist COUNTY ROUTE 04 CC 680 23.2/24.9 31 REGISTERED CIVIL ENGINEER DATE

February 8, 2010 PLANS APPROVAL DATE

THE STATE OF CALIFORNIA OR ITS OFFICERS OR AGENTS SHALL NOT BE RESPONSIBLE FOR THE ACCURACY OR COMPLETENESS OF SCANNED COPIES OF THIS PLAN SHEET.

URS CORPORATION
100 W. San Fernando Street
Suite 200
San Jose, CA 95113

BAY AREA TOLL AUTHORITY
101 EIGHTH STREET
0AKLAND, CA 94607

RUTA JARIWALA

No. C-73840 Exp. 6-30-11

CIVIL

#### **ROADSIDE SIGN QUANTITIES**

SHEET No.	SIGN No.	SIGN CODE	PANEL SIZE	INSTALL ROADSIDE SIGN PANEL ON EXISTING POST	INSTALL SIGN PANEL ON TOLL BOOTH	INSTALL SIGN OVERLAY (N)	METAL (BARRIER MOUNTED SIGN)	REMARKS
			FT x FT	EA	EA	ΕA	LB	
		R86 SPECIAL (CA)	2.50 x 5.50				160	NEW SIGN (BARRIER MOUNTED SIGN)
S-3	l	SPECIAL	2.50 × 2.00					NEW SIGN (BARKIER MOUNTED SIGN)
S-4	1	R82-1 CA)	2.50 × 5.00				160	NEW SIGN (BARRIER MOUNTED SIGN)
S-5	1	SPECIAL	0.92 × 0.92			1		OVERLAY "4" WITH "5"
S-5	2	SPECIAL	3.00 × 1.50	1				ADD "EFFECTIVE DATE" TO EXISTING POST
S-5	3	SPECIAL	0.42 x 0.42			1		OVERLAY "4" WITH "5"
S-5	4	SPECIAL	3.00 x 1.50	1				ADD "EFFECTIVE DATE" TO EXISTING POST
S-8	1	SPECIAL	2.50 x 2.00	1				ADD "FASTRAK REQUIRED TOLL \$2.50" TO THE EXISTING POST
S-9	1	SPECIAL	0.83 × 0.25			9		OVERLAY "\$4.00" WITH "\$5.00"-TOTAL OF 9 SIGNS
S-9	2	SPECIAL	1.75 × 0.17			9		OVERLAY "EFFECTIVE DATE" TO EXISTING SIGN-TOTAL OF 9 SIGNS
· S-9	3	SPECIAL	1.00 x 0.75			9		OVERLAY "\$4" WITH "\$5"-TOTAL OF 9 SIGNS
S-9	4	SPECIAL	8.75 × 1.17			1		OVERLAY "CARPOOL OK" WITH "CARPOOL \$2.50"
S-9	5	SPECIAL	2.00 × 2.50		1			NEW SIGN ON TOLL BOOTH 3
ТОТ	AL			3	1	30	320	

(N) = NOT A SEPARATE PAY ITEM. FOR INFORMATION ONLY.

DEPARTMENT OF TRANSPORTATION

CALIFORNIA

ᆼ

Ge Caltans

#### SIGN PANEL SUMMARY

							3	SIGN PANEL	. SUMMAK	Y				
							SIZE FACIN	G MATERIAL			SIGN PANEL SUBSTRATE MATERIAL	OVERLAY		
						BACKGRO	DUND	LE	GEND	PROTECTIVE FILM	ROADSIDE	(SINGLE SHEET OVERLAY FLAT/		
SHEET No.	SIGN No.	SIGN CODE	PANEL SIZE	AREA	SINGLE FACED	SHEETING COLOR	RETRO- REFLECTIVE	SHEETING COLOR	RETRO- REFLECTIVE	PREMIUM	SINGLE SHEET UNFRAMED ALUMINUM (0.063")	NO RADI/ NO BORDER)	REMARKS	
			FT × FT	SQFT	1	002011	ASTM TYPE	302011	ASTM TYPE		SQFT	SQFT		
6.7	1	R86 SPECIAL (CA)	2.50 × 5.50	13.75	X	WHITE/BLACK	III/PLAIN	WHITE/BLACK	III/PLAIN	Х	13.75			
S-3	ļ ļ	SPECIAL	2.50 × 2.00	5.00	Х	WHITE	III	BLACK	PLAIN	X	5.00			
S-4	1	R82-1 CA)	2.50 × 5.00	12.50	X	WHITE/BLACK	III/PLAIN	WHITE/BLACK	III/PLAIN	X	12.50			
S-5	1	SPECIAL	0.92 X 0.92	0.85	Х	WHITE	III	BLACK	PLAIN	Х		0.85		٦
S-5	2	SPECIAL	3.00 X 1.50	4.50	X	WHITE	III	BLACK	PLAIN	X	4.50			
S-5	3	SPECIAL	0.42 X 0.42	0.18	Х	WHITE	III	BLACK	PLAIN	Х		0.18		
S-5	4	SPECIAL	3.00 X 1.50	4.50	X	WHITE	III	BLACK	PLAIN	Х	4.50			
S-8	1	SPECIAL	2.50 × 2.00	5.00	Х	WHITE	III	BLACK	PLAIN	X	5.00			
S-9	1	SPECIAL	0.83 × 0.25	0.21	X	WHITE	III	BLACK	PLAIN	Х		9 X 0.21 = 1.89	TOTAL OF 9 SIGNS	
S-9	2	SPECIAL	1.75 × 0.17	0.30	X	WHITE	III	BLACK	PLAIN	X		9 X 0.30 = 2.70	TOTAL OF 9 SIGNS	5
S-9	3	SPECIAL	1.00 x 0.75	0.75	Х	WHITE	III	BLACK	PLAIN	Х		9 X 0.75 = 6.75	TOTAL OF 9 SIGNS	ذ
\S=\{\sigma}		SPECIAL	8-75 × 1-17	19-24	X	WHITE		BLACK	PLAIN			10.24		
\$-9.	5	SPECIAL	2.00 x 2.50	5.00	X	WHITE/BLACK	III/ <del>PLAIN</del>	<del>-WHITE</del> /BLACK	HH/PLAIN	X	5.00			- ) [ ]
i TO	OTAL	T	$\gamma$		+					1	50.25	1 22.61		

BENICIA BRIDGE SIGN QUANTITIES


NO SCALE


SQ-1


TREVISED PER ADDENDUM NO.1 DATED FEBRUARY 22, 2010

RELATIVE BORDER SCALE
IS IN INCHES

USERNAME => beshoy_demyan
DGN FILE => ...\08_Benicia\SIGNS\SQ-1-AD.dgn

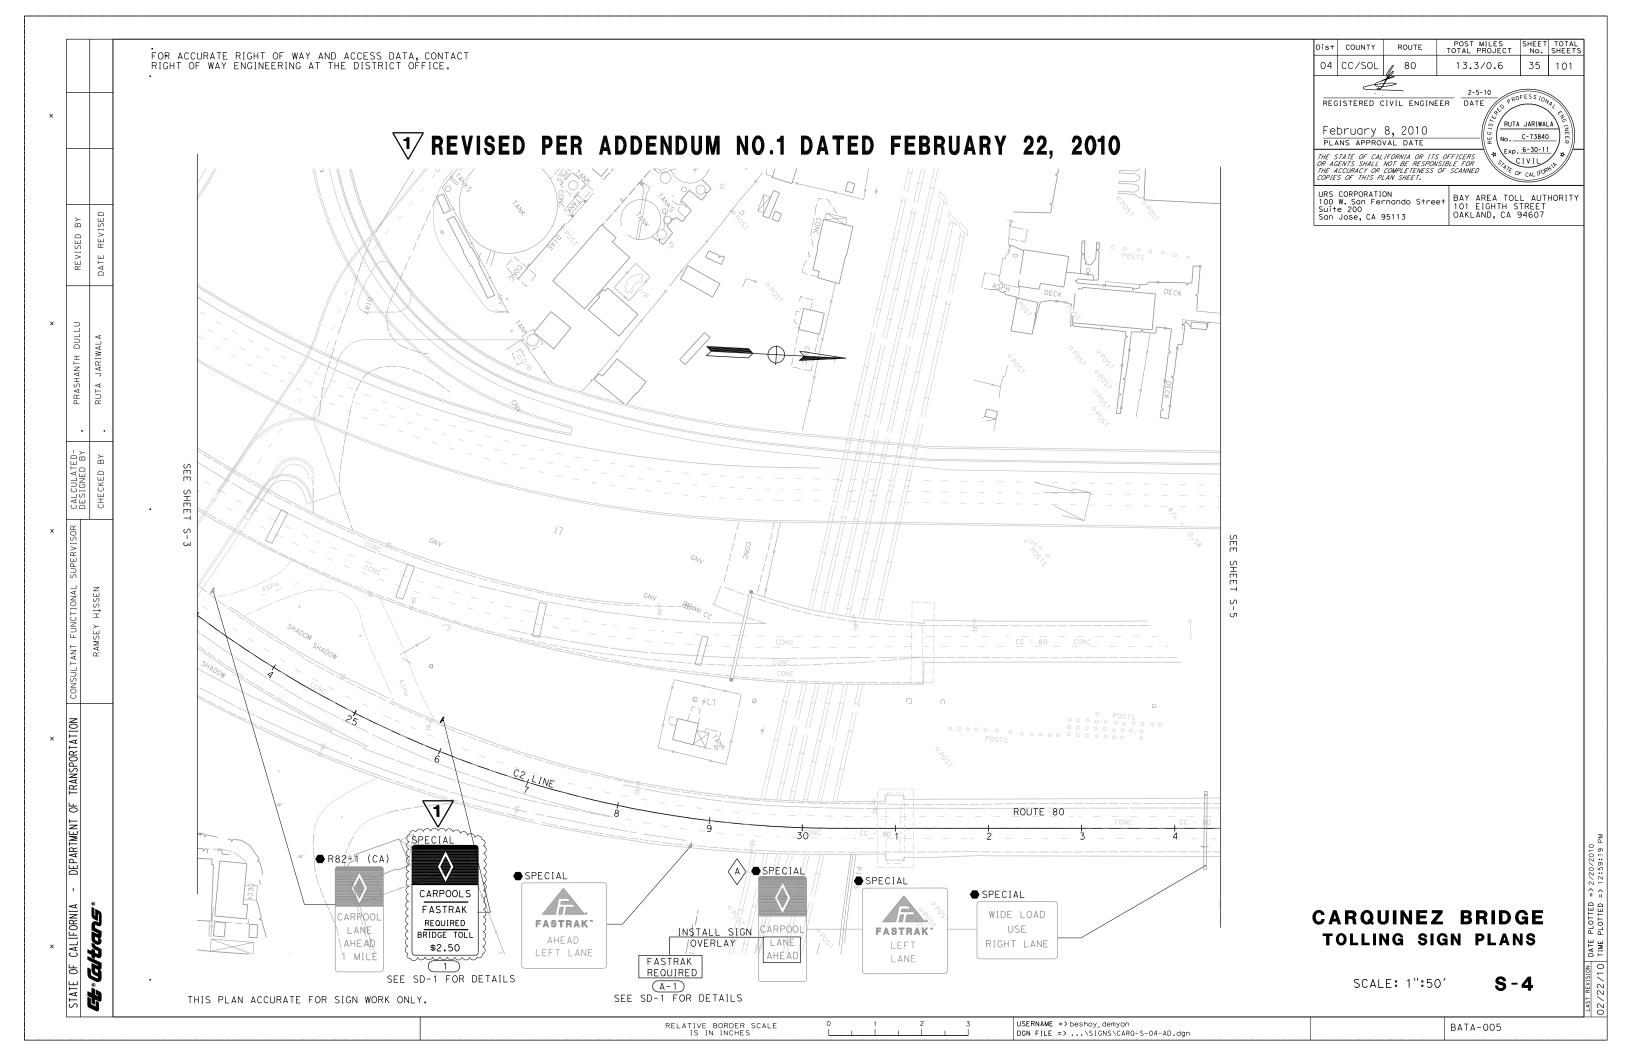

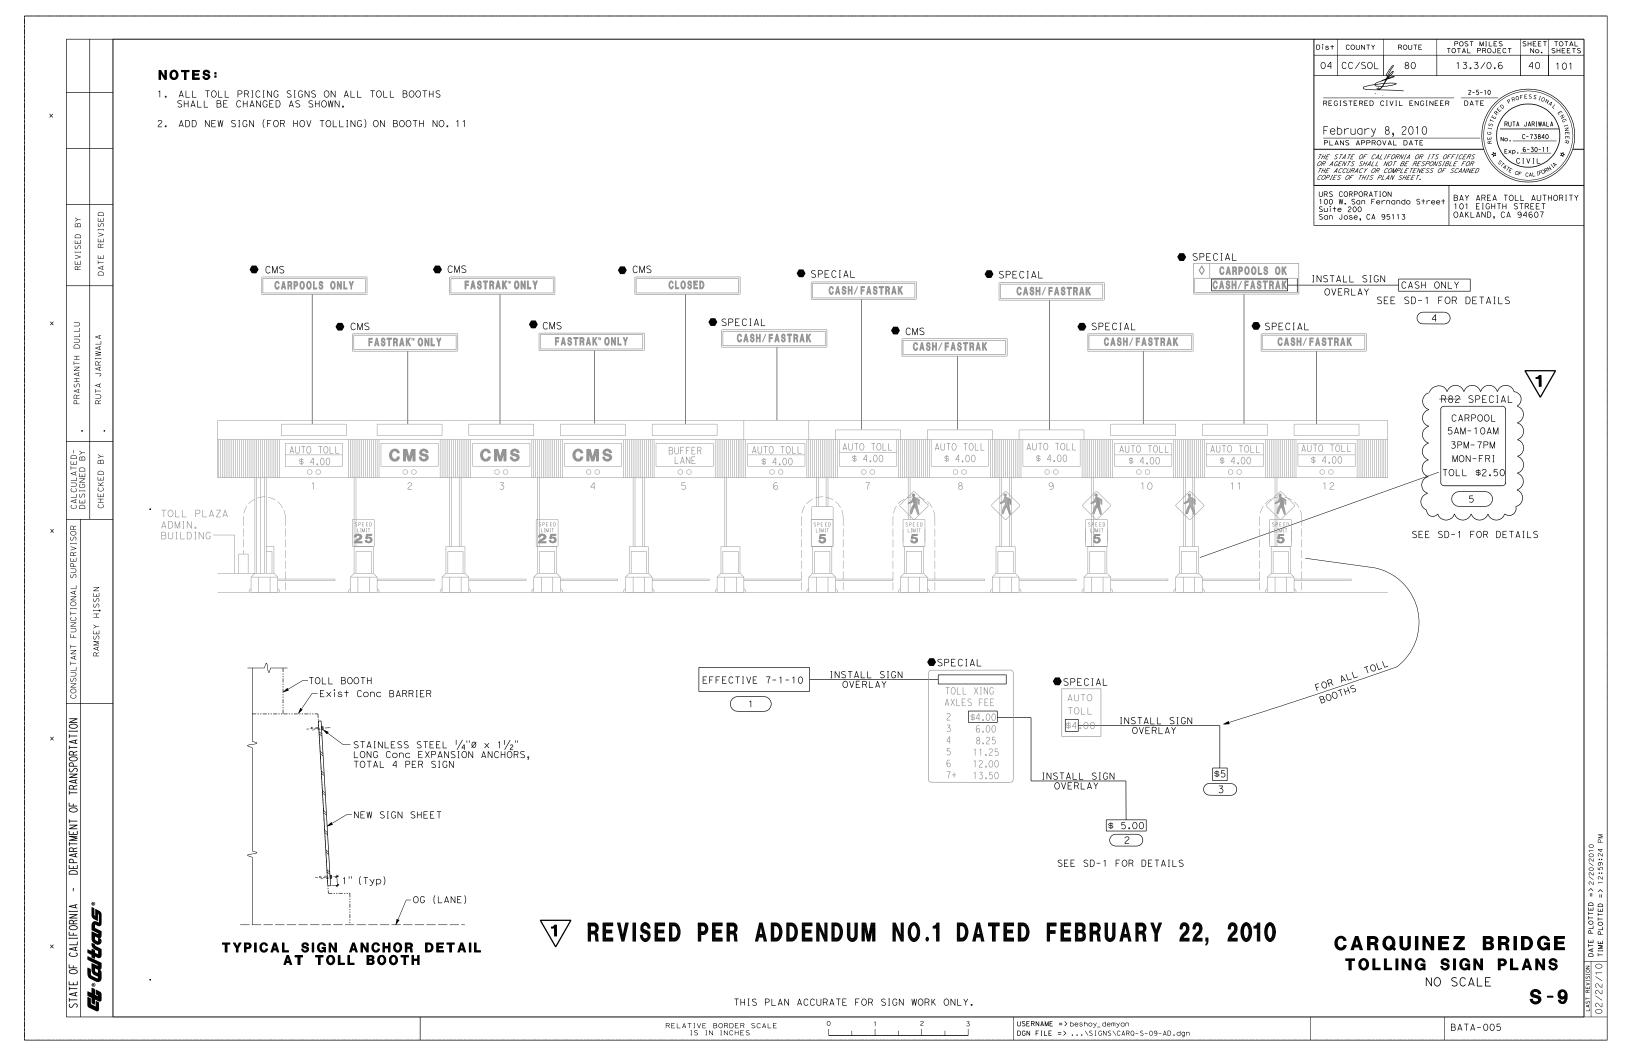


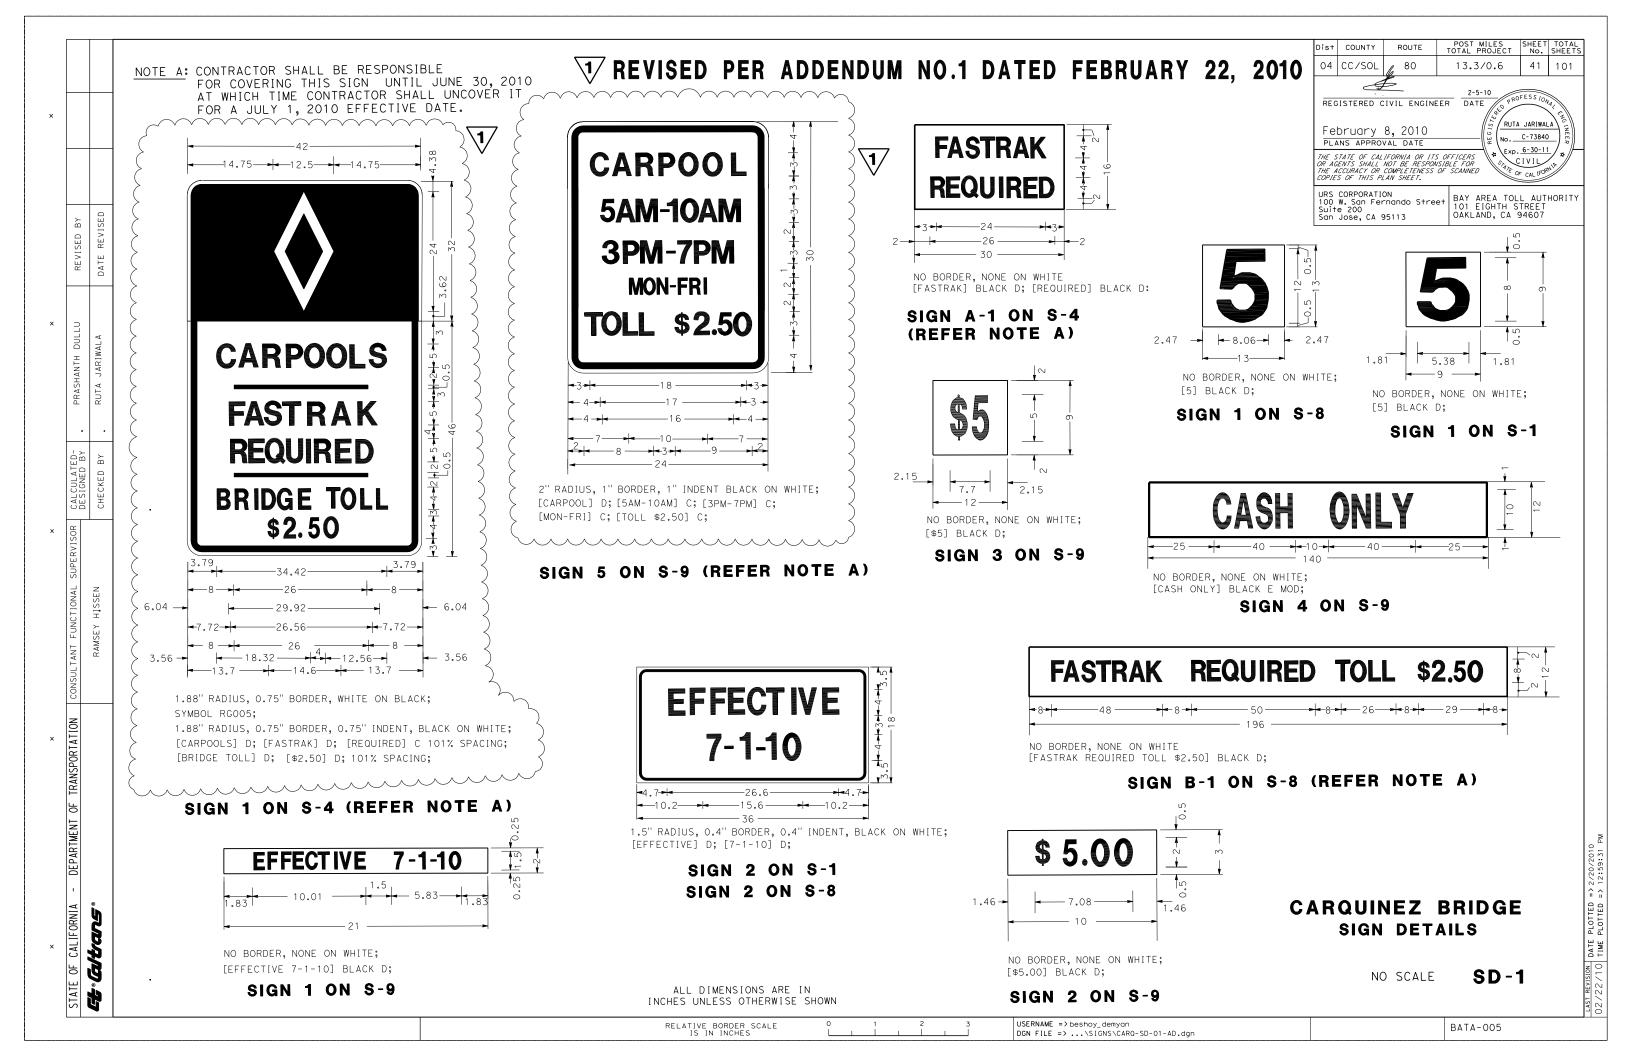



									OVERH	EAD SIG	N QUAN	ITITIES					Dist COUNTY ROUTE  04 CC/SOL 80  REGISTERED CIVIL ENGIN	POST MILES SHEET TOTAL PROJECT No. SI  13.3/0.6 42  2-5-10  POFESS/ONA,  DATE  PROFESS/ONA,
			SHEET	STRUCTUR		SIGN	PANEL	SIZE	INSTAL	L SIGN OVER	LAY (N)			REMARKS				RUTA JARIWALA
			No.	No.	No.	CODE	FT ×	( FT		EA							February 8, 2010 PLANS APPROVAL DATE	No. <u>C-73840</u> Exp. <u>6-30-11</u>
			S-4	А	A - 1	SPECIAL	2.50 X	1.33		1		OVEF	RLAY "LANE AHEA	D" WITH "FASTRAK REQU	UIRED"		THE STATE OF CALIFORNIA OR 17 OR AGENTS SHALL NOT BE RESPO THE ACCURACY OR COMPLETENESS COPIES OF THIS PLAN SHEET.	S OFFICERS NSIBLE FOR OF SCANNED
			S-8	В	B-1	SPECIAL	16.33	X 1.00		1		OVERLAY	"TOLL-FREE" WIT	H "FASTRAK REQUIRED	TOLL \$2.50"		COPIES OF THIS PLAN SHEET.  URS CORPORATION	
		(11)	NOT		TO:					2							100 W. San Fernando Stre Suite 200	BAY AREA TOLL AUTHO 101 EIGHTH STREET OAKLAND, CA 94607
REVISED BY ATE REVISE		(IV)	= NOT	A SEPARATE	PAT ITEM.	FOR INFORMATI	ON ONLY.		ROAD	SIDE SI	GN QUAI	NTITIES					San Jose, CA 95113	OANEAND, CA 31001
REV		SHEE No.		SIGN No.	SIGN CODE	PANEL SIZE	INSTALL SIC TOLL BOO		INSTALL SIGN OVERLAY (N)	REPLACE SIGN PANEL (ROADSIDE SIGN)	(STRA SADDLE	LL SIGN AP AND BRACKET			REMAR	ıks		
DULLU 'ALA		S-1			PECIAL	FT x FT 0.75 x 0.75	EΑ		E A 1	EA	METHOL	O) (SSBM)		OVER	LAY "4" WITH "	5"		
		S-1				$\frac{0.75 \times 0.75}{3.00 \times 1.50}$			1	1						WITH "NEW DATE"		
T   1		S-4				3.50 × 6.50						1			EW SIGN (ON LU			
PRASH		S-8				1.08 × 1.08			1						OVERLAY "4" W			
		S-8 S-9				$\frac{3.00 \times 1.50}{1.75 \times 0.17}$			12	1			OVERLAY			WITH "NEW DATE" - FOR TOLL BOOTHS 1-12 (12 :	SIGNS)	
		S-9				0.83 × 0.25			12							DLL BOOTHS 1-12 (12 SIGNS)		
CALCULATED- DESIGNED BY CHECKED BY	_ <b>1</b>	7 5-9				1.00 × 0.75			12							BOOTHS 1-12 (12 SIGNS)		
SIGNE	\	/{   s-9		5 <del>R82</del>	- SPECIAL	1.67 × 1.00 2.00 × 2.50	1						·····	***************************************	INSTALL NEW	ITH "CASH ONLY"	₩ <u></u>	
E EE		•				INFORMATION			39	2		1						
CTIONAL SUPERVISO		CUEST		SIGN	SIGN	DANIEL CLZE	ADEA	SINGL		BACK	NEL SUM		FACING MATERIA	-	PROTECTIVE	SIGN PANEL SUBSTRATE MATERIAL ROADSIDE	OVERLAY	
ž I 🛴		SHEET No.		No.	CODE	PANEL SIZE	AREA	FACE	)						FILM	SINGLE SHEET	(SINGLE SHEET OVERLAY FLAT/ NO RADI/	REMARKS
RAMSE										HEETING COLOR	RETROREFI ASTM 1		SHEETING COLOR	RETROREFLECTIVE ASTM TYPE	PREMIUM	UNFRAMED ALUMINUM (0.063")	NO BORDER)	
		S-1		1	SPECIAL	FT × FT 0.75 × 0.75	SQFT 0.56	X		VHITE	III		BLACK	DI ATAI	X	SQF T	SQFT 0.56	
		Z S-1				3.00 x 1.50		X		VHITE	III		BLACK	PLAIN PLAIN	X	4.50	0.36	
1	🏋	\\\\\\\\\\\\\\\\\\\\\\\\\\\\\\\\\\\\\\		1 R8	<del>32</del> SPECIAL	3.50 × 6.50	22.75	X		TE/BLACK	III/PLAI	[N	WHITE/BLACK		x	22.13		
ĺ		S-4		<b>1</b> − 1	SPECIAL	2.50 X 1.33	3.33	X	,	VHITE	III		BLACK	PLAIN	······		3.32	
		S-8 S-8			SPECIAL	1.08 X 1.08 3.00 X 1.50	1.17 4.50	X		VHITE VHITE	III		BLACK BLACK	PLAIN PLAIN	X	4.50	1.17	
	-	S-8			SPECIAL SPECIAL	16.33 X 1.00	16.33	X		WHITE	III		BLACK	PLAIN	X	7.50	16.33	
5		S-9		1	SPECIAL	1.75 X 0.17	0.30	X		VHITE	III		BLACK	PLAIN	X		12 X 0.30 = 3.60	TOTAL OF 12 SIGNS
		S-9		2	SPECIAL	0.83 X 0.25	0.21	Х		VHITE	III		BLACK	PLAIN	Х		12 X 0.21 = 2.52	TOTAL OF 12 SIGNS
		S-9 S-9			SPECIAL	1.00 X 0.75 11.67 × 1.00	0.75	X		VHITE VHITE	III		BLACK BLACK	PLAIN PLAIN	X		12 X 0.75 = 9.00 11.67	TOTAL OF 12 SIGNS
		S-9 S-9		5 R8	32 SPECIAL	2.00 X 2.50	5.00	X		TÉ/ <del>BLAC</del> K	III/ <del>PLA</del>	<del>I</del> N	WHITE/BLACK	HH/PLAIN	X	5.00	· · · · · · · · · · · · · · · · · · ·	
<b>Gitans</b>		1		STAL												36.75	CARQUINE: SIGN QUA	
STATE OF CALIFORNIA								7	₹ RE	VISED	PER A	ADDEN	IDUM NO	.1 DATED	FEBRUA	RY 22, 2010	SIGN QUA	

BATA-005

USERNAME => beshoy_demyan
DGN FILE => ...\SIGNS\CARQ-SQ-01-ADdgn.dgn

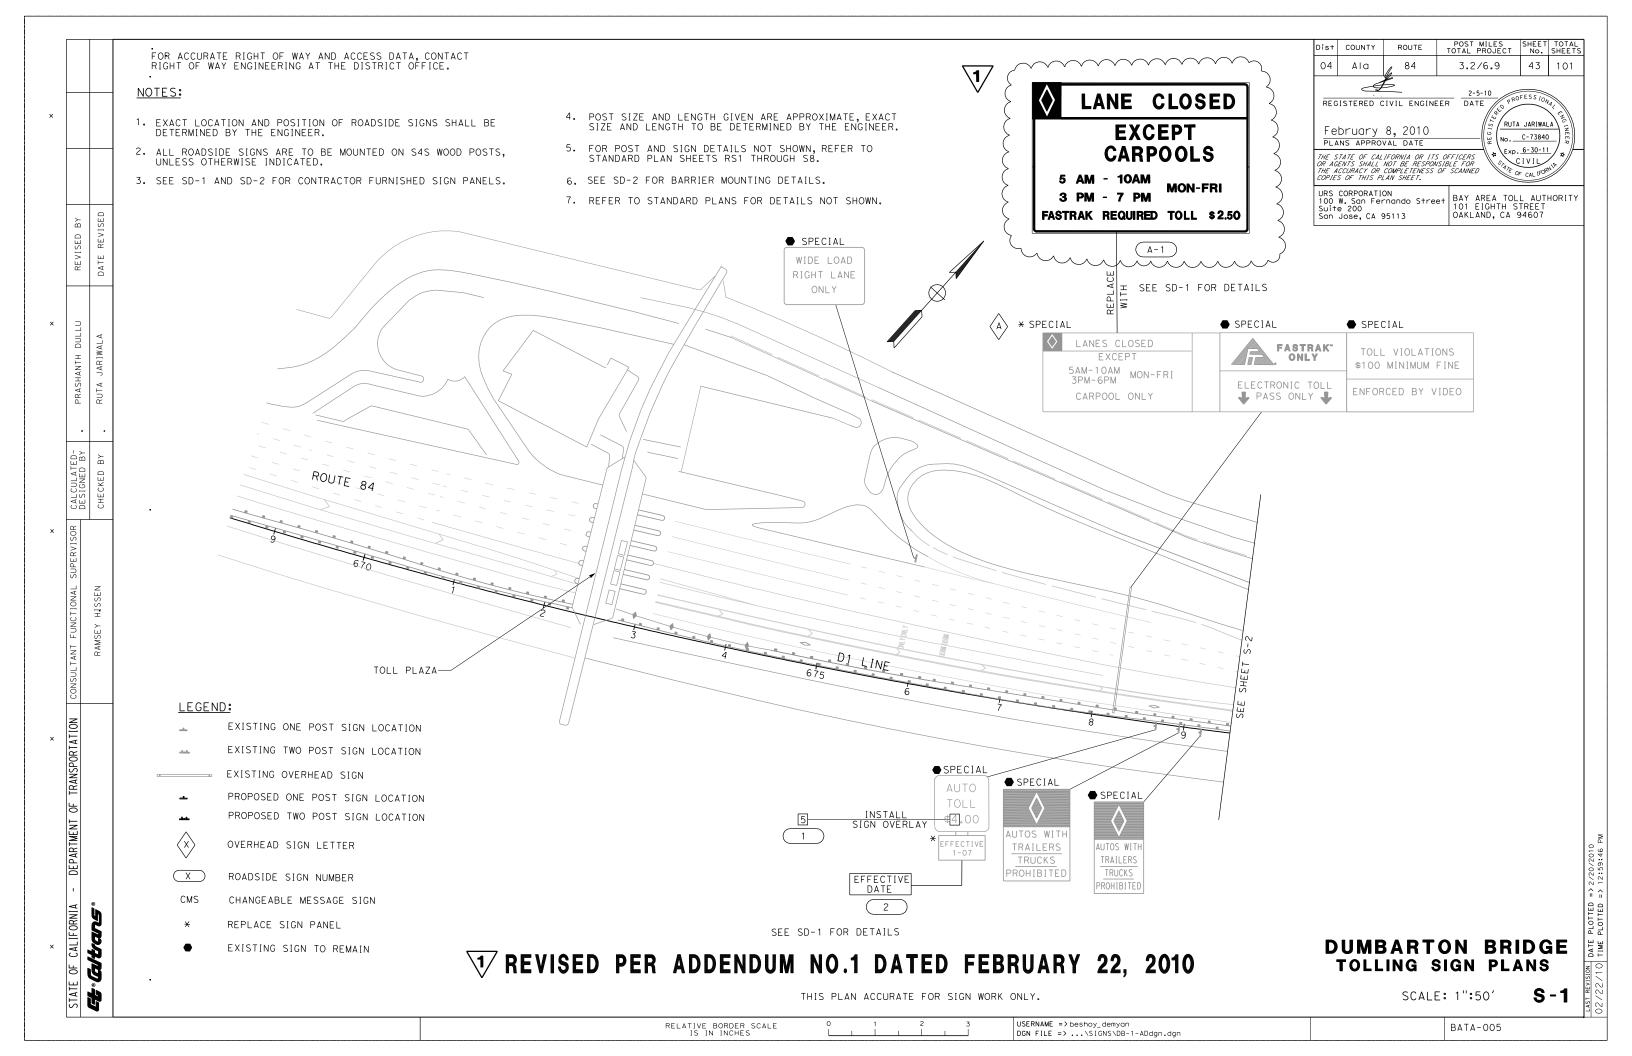

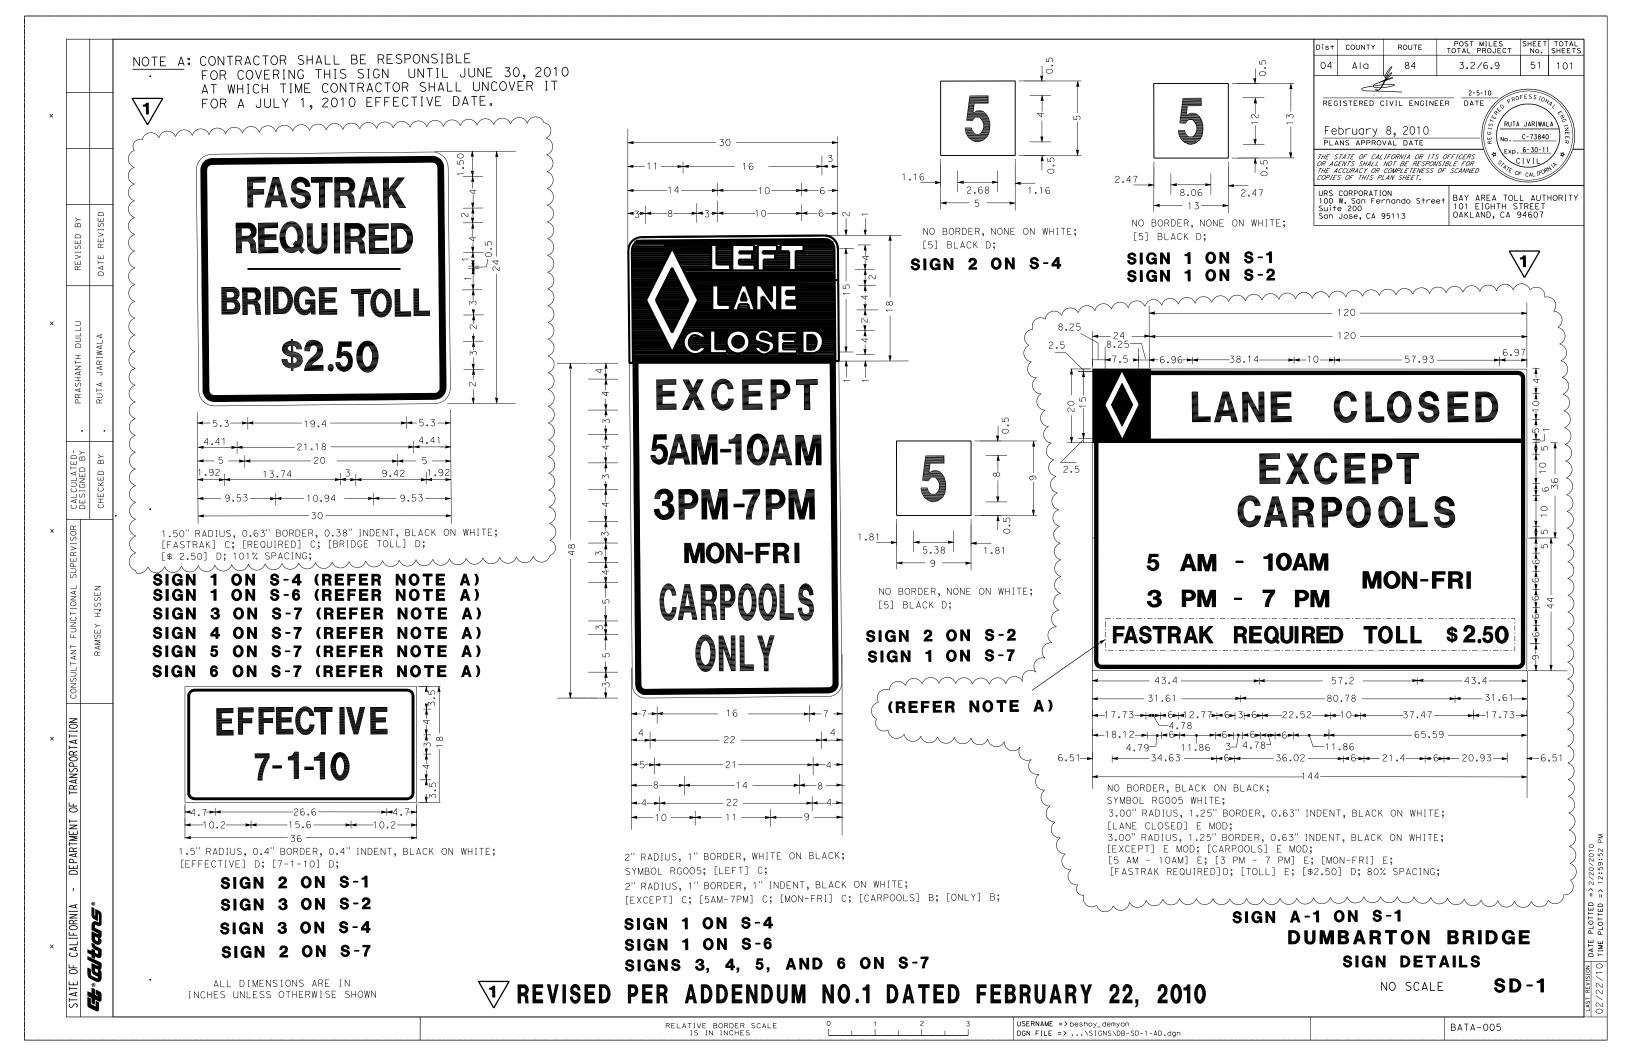

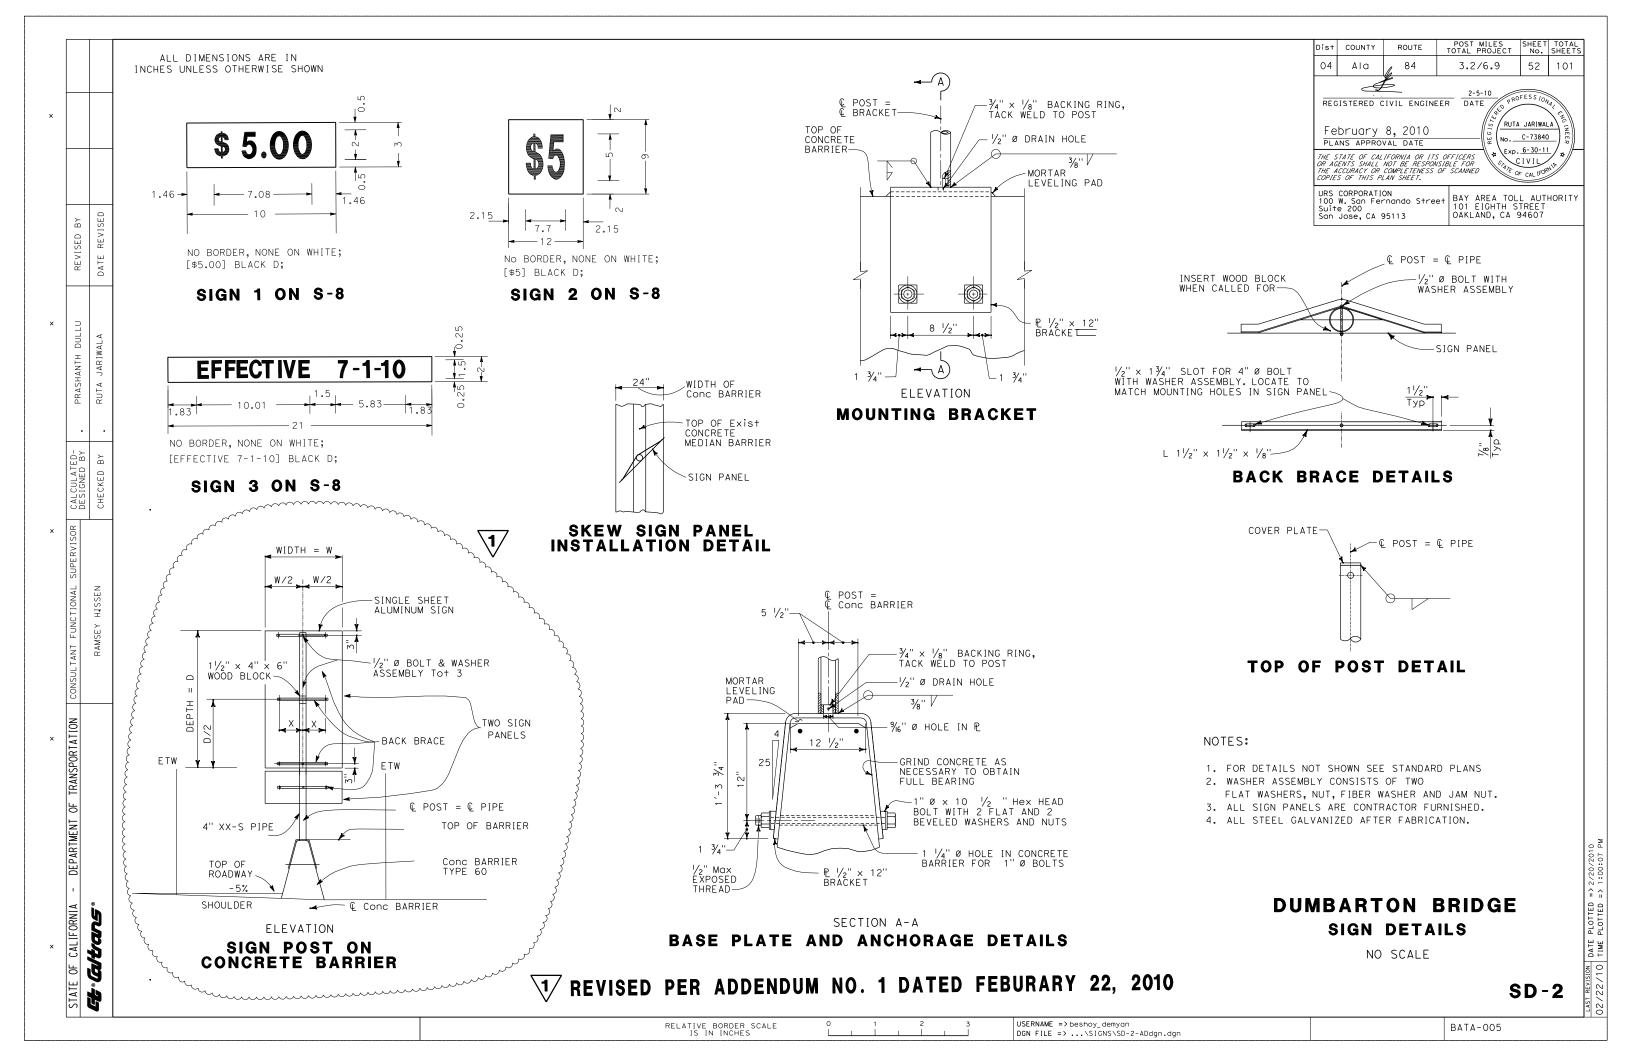

Dist COUNTY 54 | 101 04 CC/SOL 80 13.3/0.6 £ 2-5-10 REGISTERED CIVIL ENGINEER DATE RUTA JARIWALA February 8, 2010
PLANS APPROVAL DATE No. C-73840 Exp. 6-30-11 THE STATE OF CALIFORNIA OR ITS OFFICERS OR AGENTS SHALL NOT BE RESPONSIBLE FOR THE ACCURACY OR COMPLETENESS OF SCANNED COPIES OF THIS PLAN SHEET. URS CORPORATION 100 W. San Fernando Street Suite 200 San Jose, CA 95113 BAY AREA TOLL AUTHORITY 101 EIGHTH STREET OAKLAND, CA 94607 SIGN PANEL SUMMARY SIZE FACING MATERIAL PRASHANTH DULLU RUTA JARIWALA



CHECKED BY

RAMSEY HISSEN

DEPARTMENT OF TRANSPORTATION | CONS

Et atas

					SINGLE FACED		SIZE FACIN	NG MATERIAL			SIGN PANEL SUBSTRATE MATERIAL	_	OVERLAY	REMARKS
SHEET No.		SIGN CODE				BACKGRO	DUND	LEGEN	)	PROTECTIVE FILM	ROADSIDE	OVERHEAD	(SINGLE SHEET OVERLAY FLAT/ NO RADI/ NO BORDER)	
	T SIGN No.		PANEL SIZE	AREA		SHEETING COLOR	RETRO- REFLECTIVE	SHEETING COLOR	RETRO- REFLECTIVE ASTM TYPE	PREMIUM	SINGLE SHEET UNFRAMED ALUMINUM (0.063")	FORMED WITH RSPF		
			FT × FT	SQFT		332311	ASTM TYPE	COLOIT			SQFT	SQFT	SQFT	
S-1	1	SPECIAL	1.08 X 1.08	1.17	X	WHITE	III	BLACK	PLAIN	X			1.17	
S-1	2	SPECIAL	3.QQ X 1.5Q	~~4.5Q~	~~~~	WHITE		····BLACK·····	PLAIN	·····×××	4.50			
7 (~3-1	A - 1	SPECIAL	12.00 X 8.33	99.96	Х	WHITE/BLACK	III/PLAIN	WHITE/BLACK	III/PLAIN	X		99.96	7	
/ \		SPÉCIAL	1.08 X 1.08	·····	<del>\ \ \ \ \ \ \ \ \ \ \ \ \ \ \ \ \ \ \ </del>	WHITE		BLACK	PLAIN	······	<del></del>		1.17	
S-2	2	SPECIAL	0.75 X 0.75	0.56	Х	WHITE	III	BLACK	PLAIN	X			0.56	
. S-2	3	SPECIAL	3.00 X 1.50	4.50	Х	WHITE	III	BLACK	PLAIN	X	4.50			
S-4	1	R86 SPECIAL	2.50 X 5.50	13.75	X	WHITE/BLACK	III/PLAIN	WHITE/BLACK	III/PLAIN	Х	13.75			
3-4	'	SPECIAL	2.50 X 2.00	5.00	Х	WHITE	III	BLACK	PLAIN	X	5.00			
S-4	2	SPECIAL	0.42 X 0.42	0.18	X	WHITE	III	BLACK	PLAIN	X			0.18	
S-4	3	SPECIAL	3.00 X 1.50	4.50	Х	WHITE	III	BLACK	PLAIN	X	4.50			
S-6	1	R86 SPECIAL	2.50 X 5.50	13.75	X	WHITE/BLACK	III/PLAIN	WHITE/BLACK	III/PLAIN	X	13.75			
	'	SPECIAL	2.50 X 2.00	5.00	X	WHITE	III	BLACK	PLAIN	X	5.00			
S-7	1	SPECIAL	0.75 X 0.75	0.56	X	WHITE	III	BLACK	PLAIN	X			0.56	
S-7	2	SPECIAL	3.00 X 1.50	4.50	Х	WHITE	III	BLACK	PLAIN	X	4.50			
S-7	3	R86 SPECIAL	2.50 X 5.50	13.75	X	WHITE/BLACK	III/PLAIN	WHTE/BLACK	III/PLAIN	X	13.75			
3-1	3	SPECIAL	2.50 X 2.00	5.00	X	WHITE	III	BLACK	PLAIN	X	5.00			
S-7	4	R86 SPECIAL	2.50 X 5.50	13.75	X	WHITE/BLACK	III/PLAIN	WHITE/BLACK	III/PLAIN	X	13.75			
3 1		SPECIAL	2.50 X 2.00	5.00	Х	WHITE	III	BLACK	PLAIN	X	5.00			
6.7		R86 SPECIAL	2.50 X 5.50	13.75	X	WHITE/BLACK	III/PLAIN	WHITE/BLACK	III/PLAIN	X	13.75			
S-7	5	SPECIAL	2.50 X 2.00	5.00	Х	WHITE	III	BLACK	PLAIN	X	5.00			
		R86 SPECIAL	2.50 X 5.50	13.75	Х	WHITE/BLACK	III/PLAIN	WHITE/BLACK	III/PLAIN	Х	13.75			
S-7	6	SPECIAL	2.50 X 2.00	5.00	Х	WHITE	III	BLACK	PLAIN	X	5.00			
S-8	1	SPECIAL	0.83 X 0.25	0.21	X	WHITE	III	BLACK	PLAIN	Х			6 X 0.21 = 1.26	TOTAL OF 6 SIGNS
S-8	2	SPECIAL	1.00 X 0.75	0.75	X	WHITE	III	BLACK	PLAIN	X			6 X 0.75 = 4.50	TOTAL OF 6 SIGNS
S-8	3	SPECIAL	1.75 X 0.17	0.30	X	WHITE	III	BLACK	PLAIN	X			6 X 0.30 = 1.80	TOTAL OF 6 SIGNS
	TOTAL										130.50	99.96	11.20	

# TREVISED PER ADDENDUM NO.1 DATED FEBRUARY 22, 2010


# DUMBARTON BRIDGE SIGN QUANTITIES


NO SCALE


**SQ-2** 


RELATIVE BORDER SCALE 0 1 2 3 USERNAME => besho


USERNAME => beshoy_demyan
DGN FILE => ...\SIGNS\DB-SQ-Q2-AD.dgn

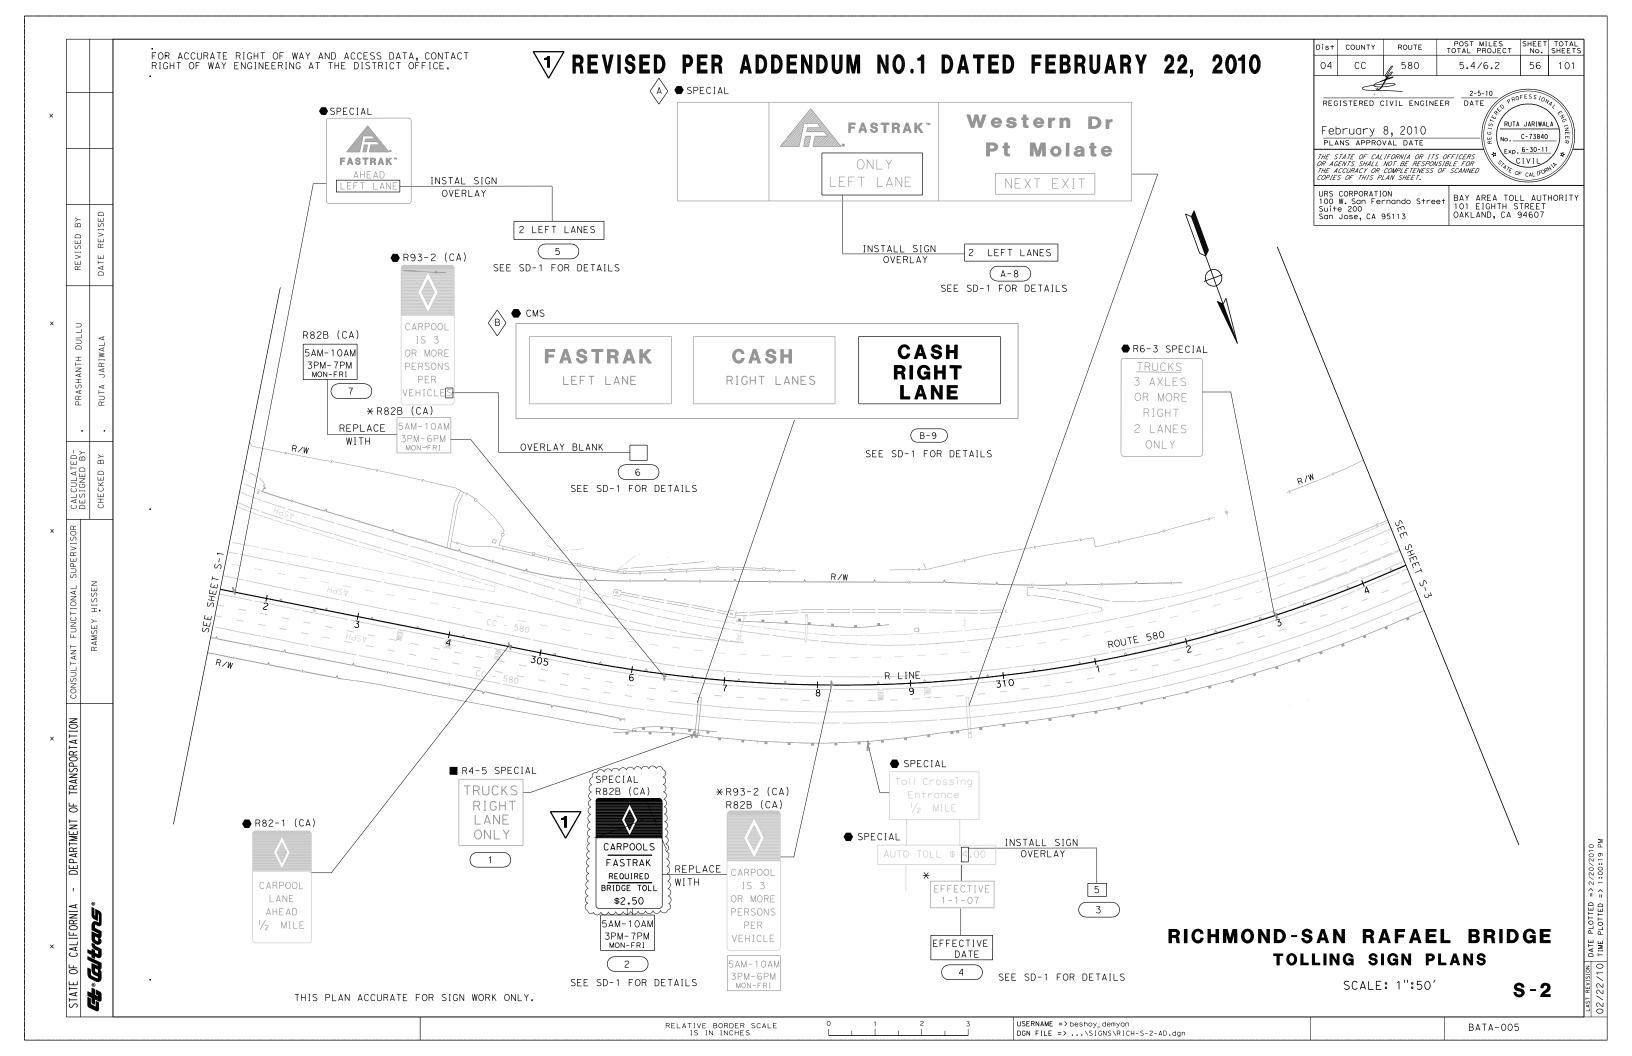


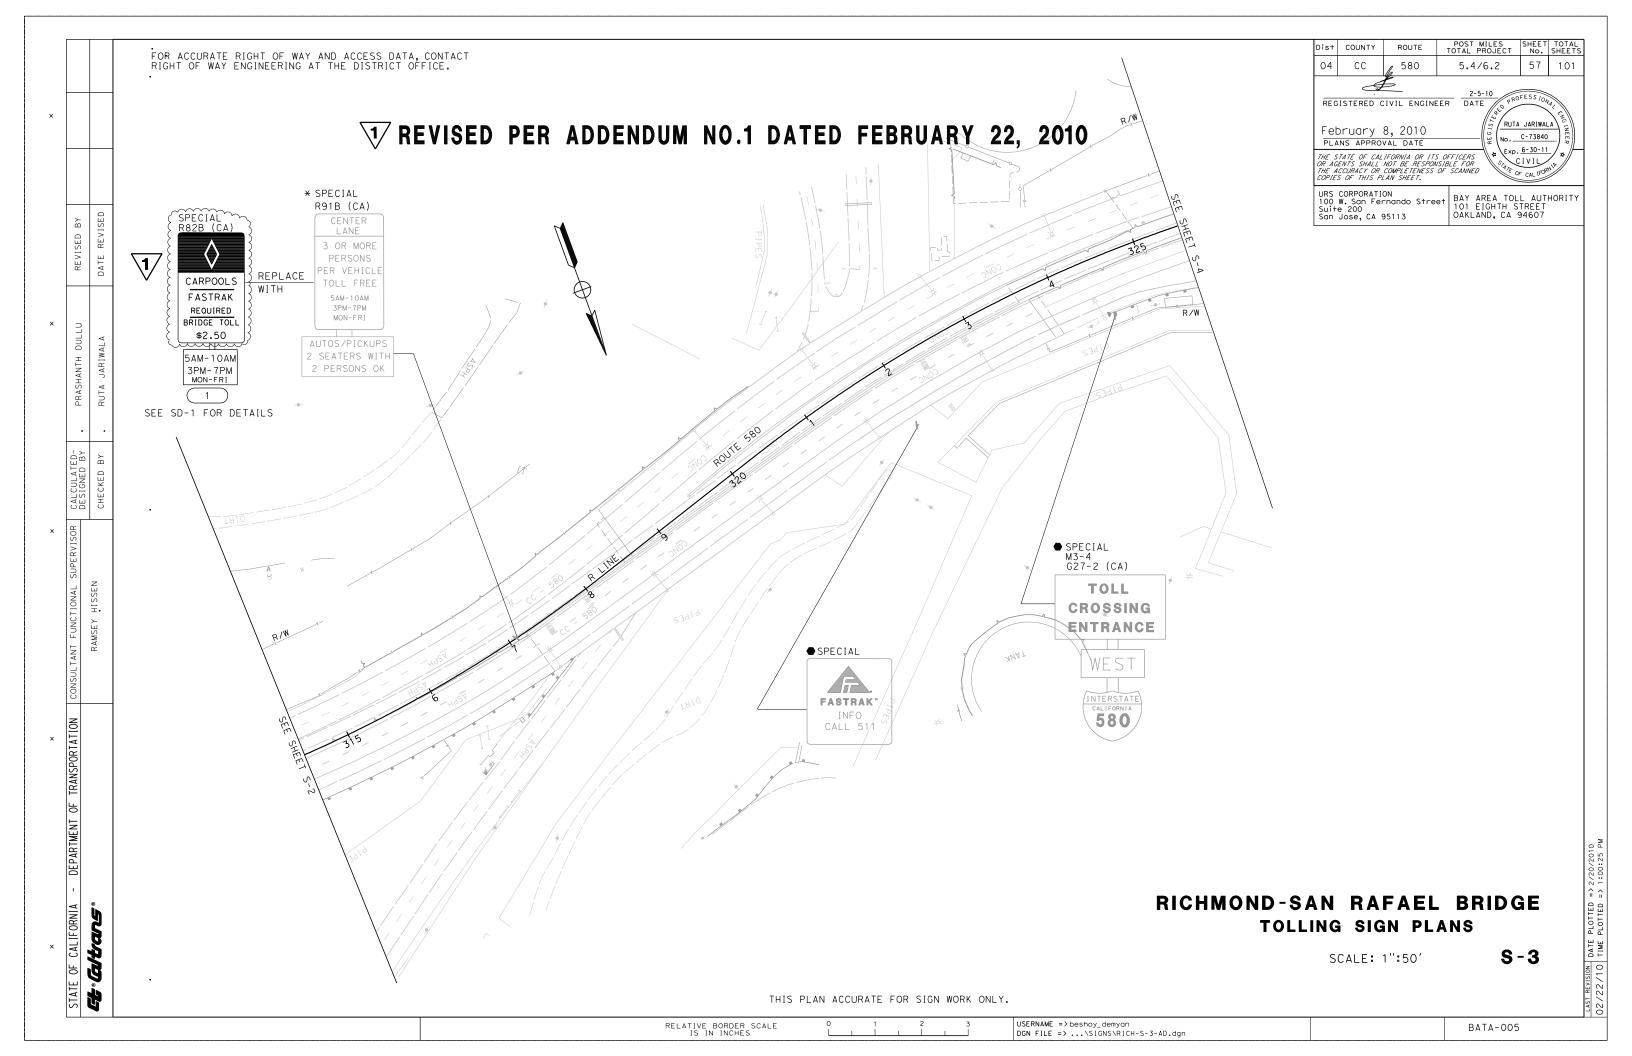


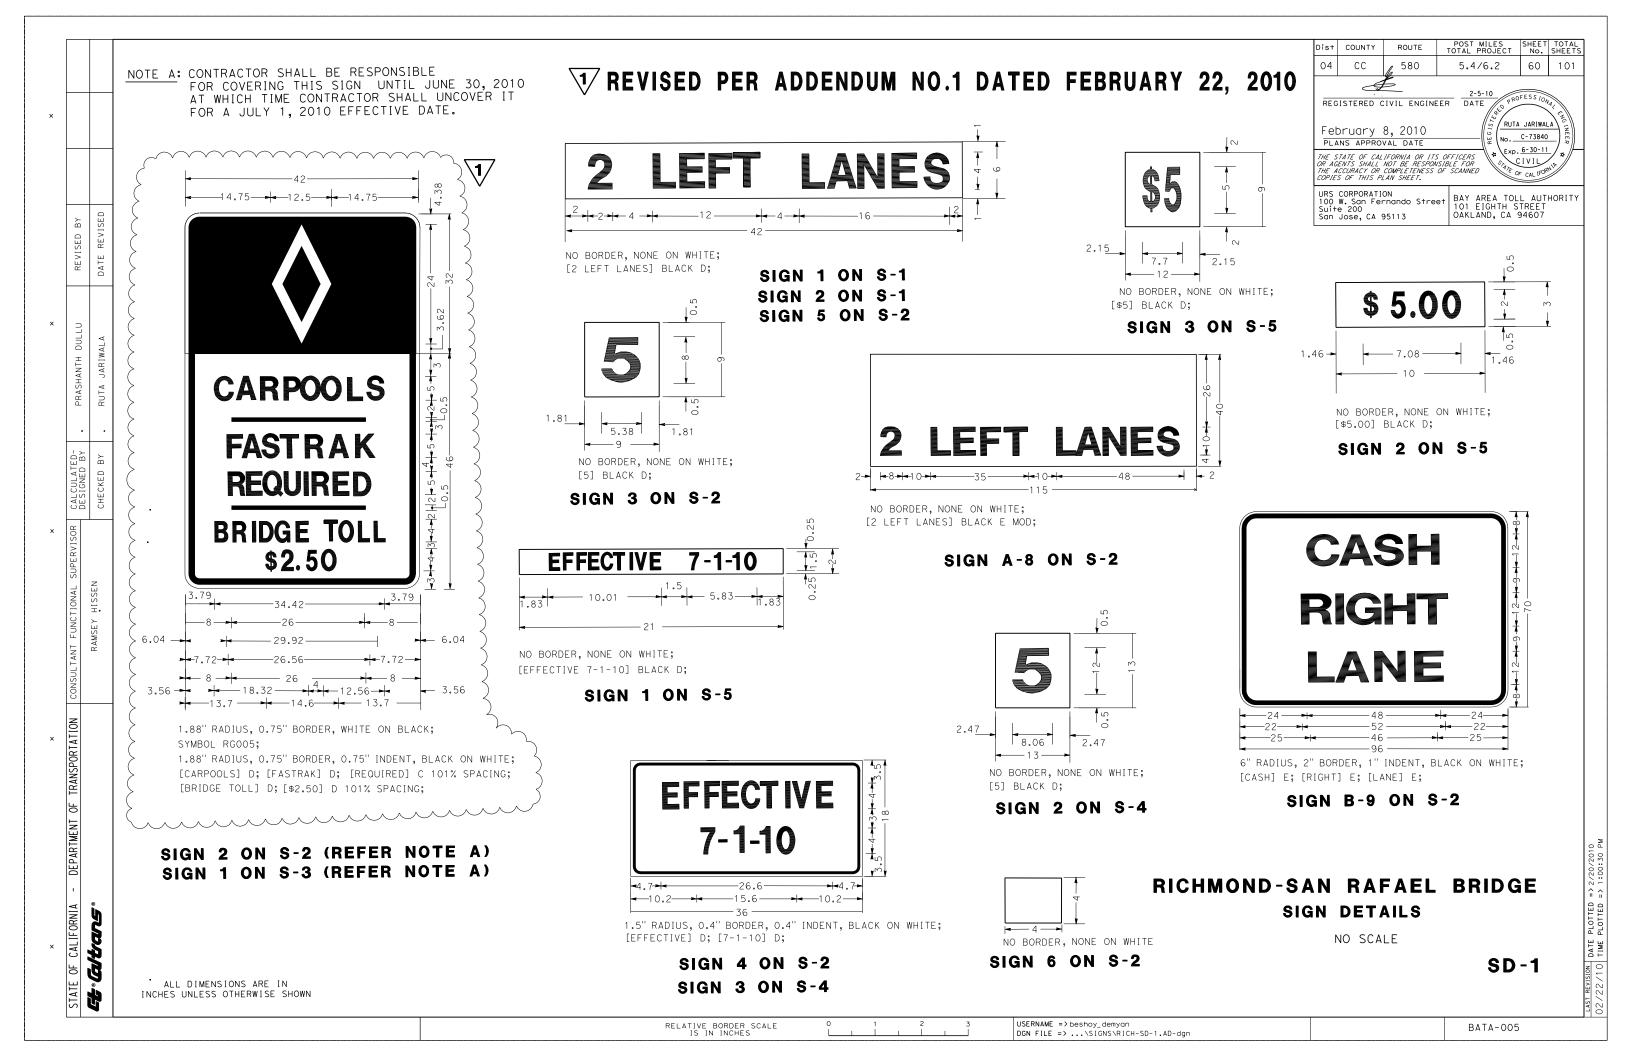


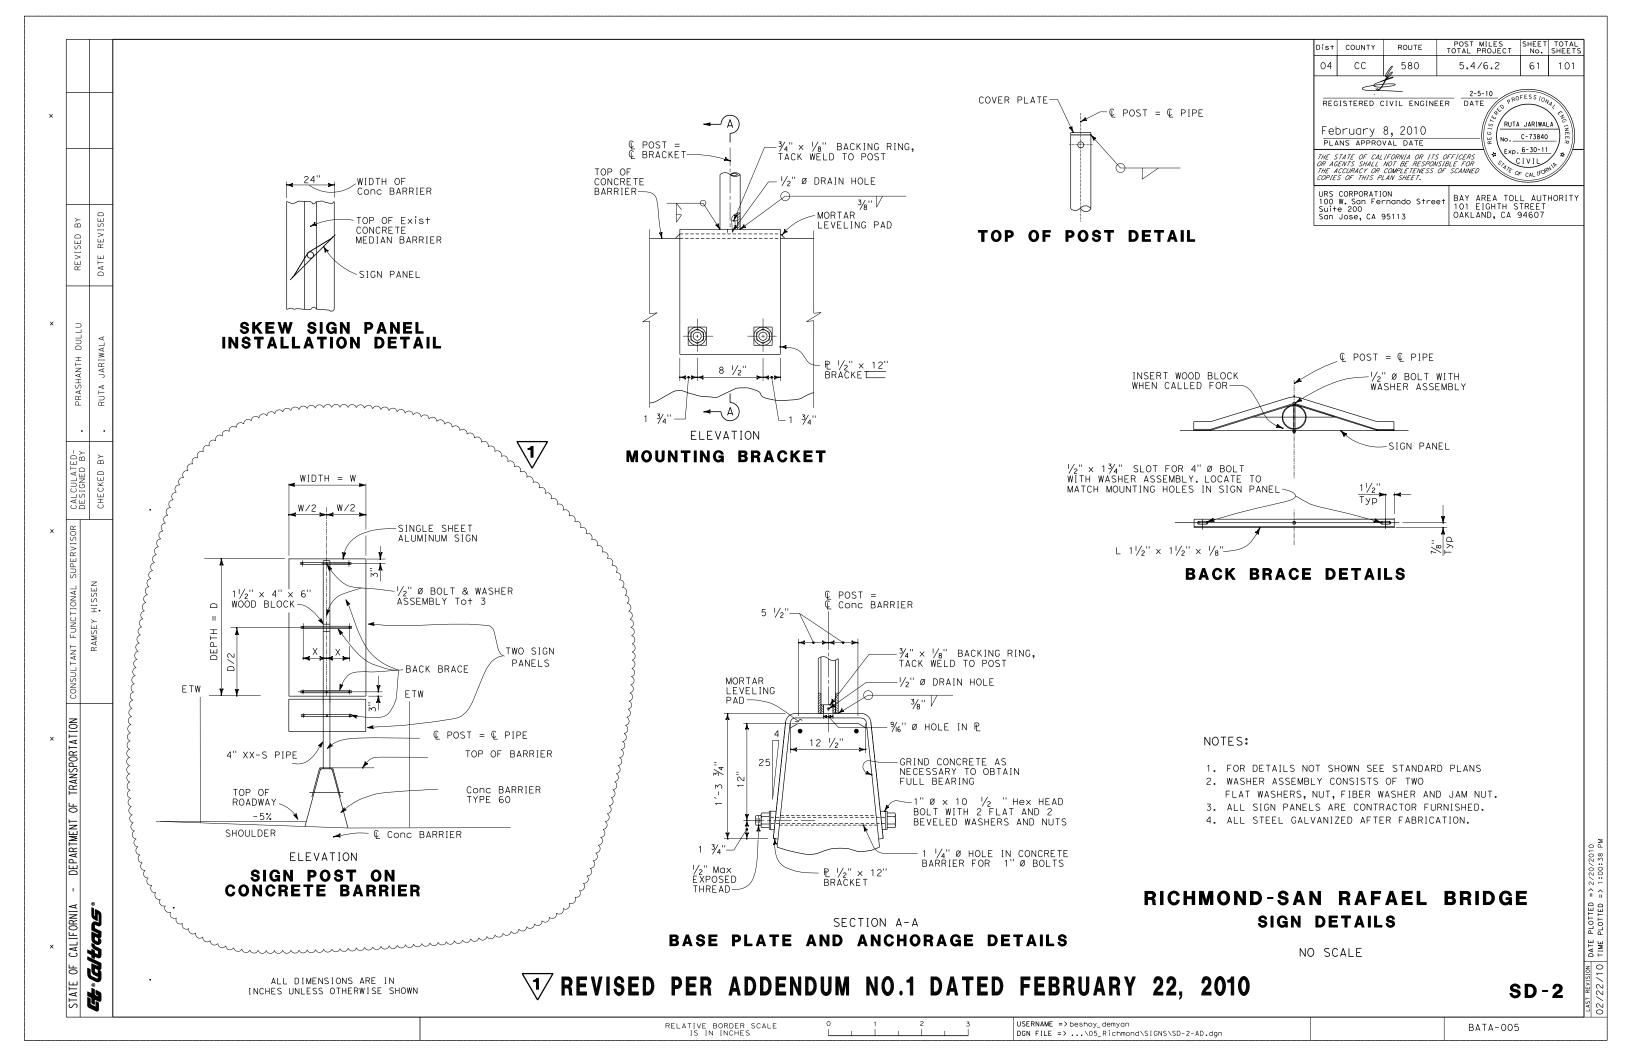


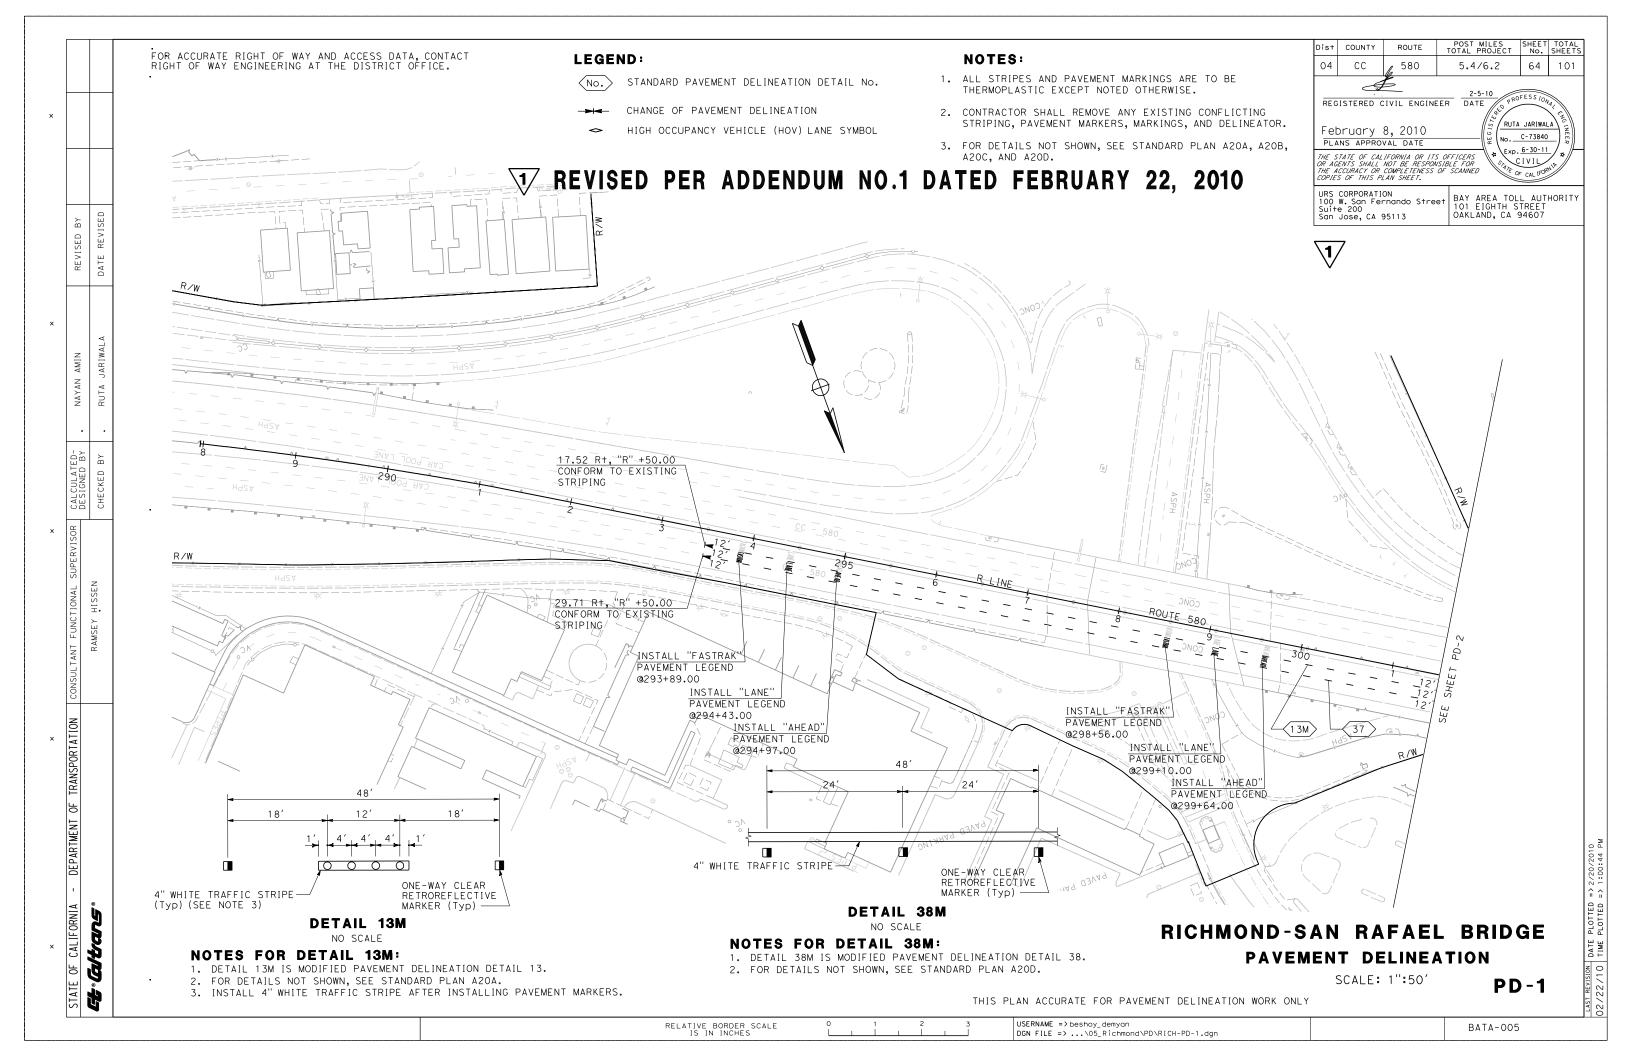

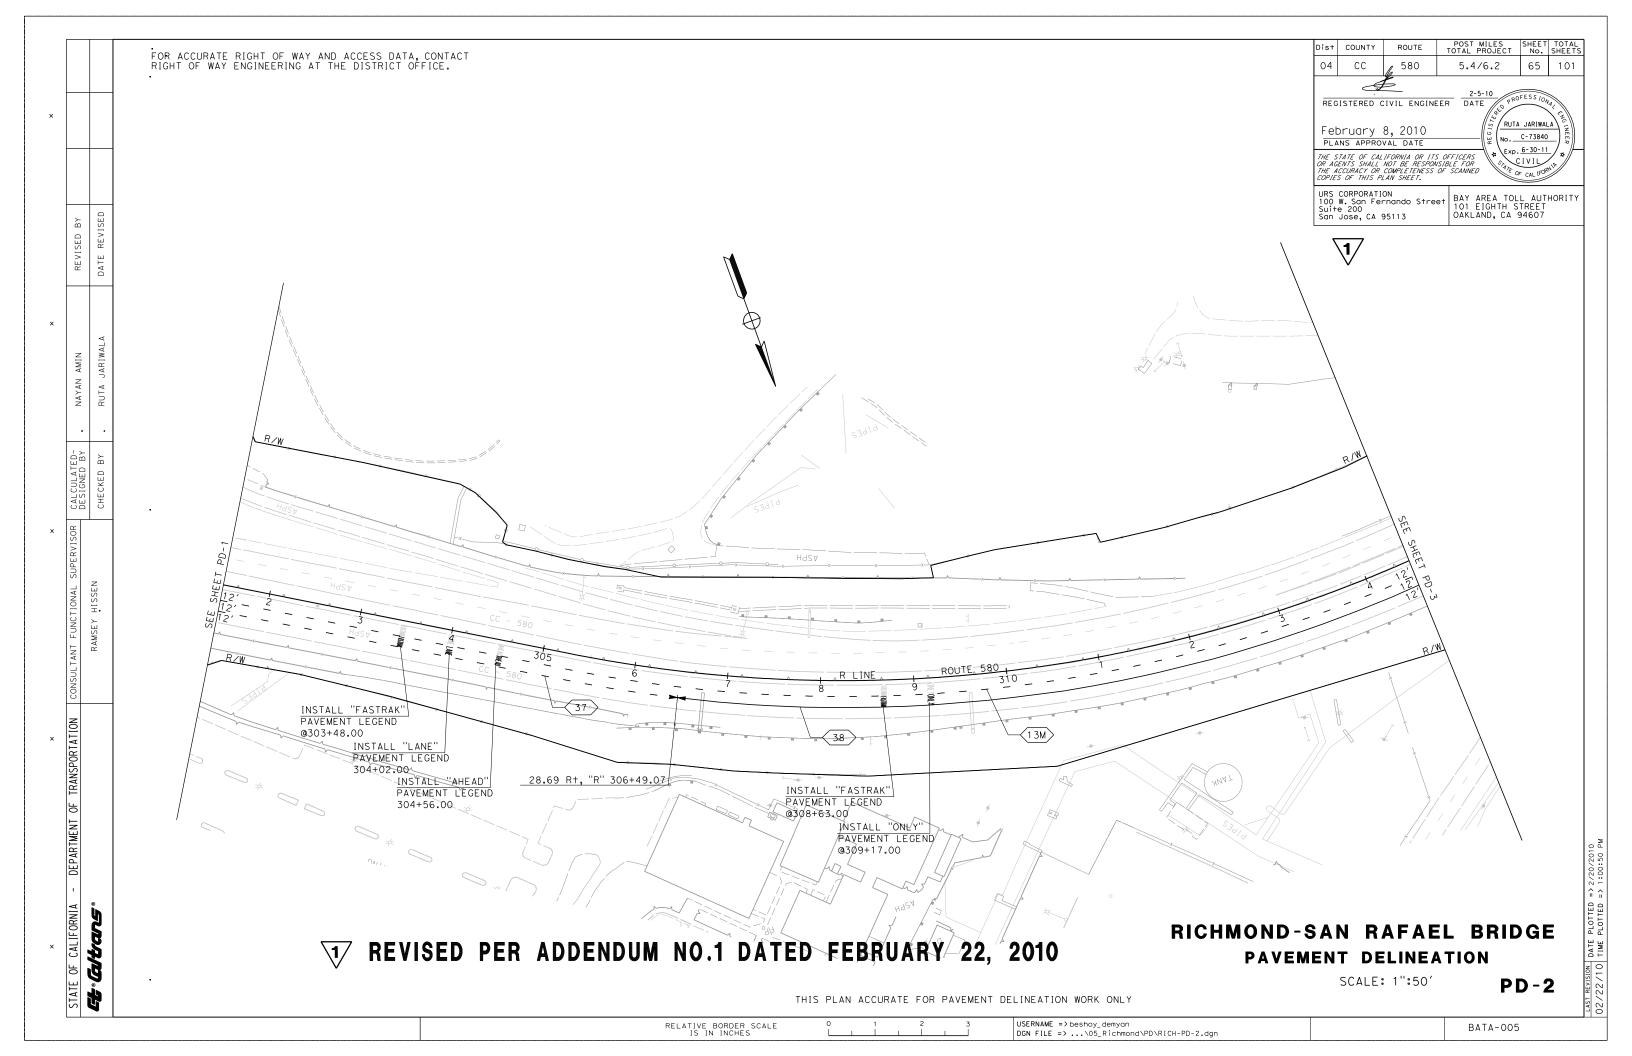

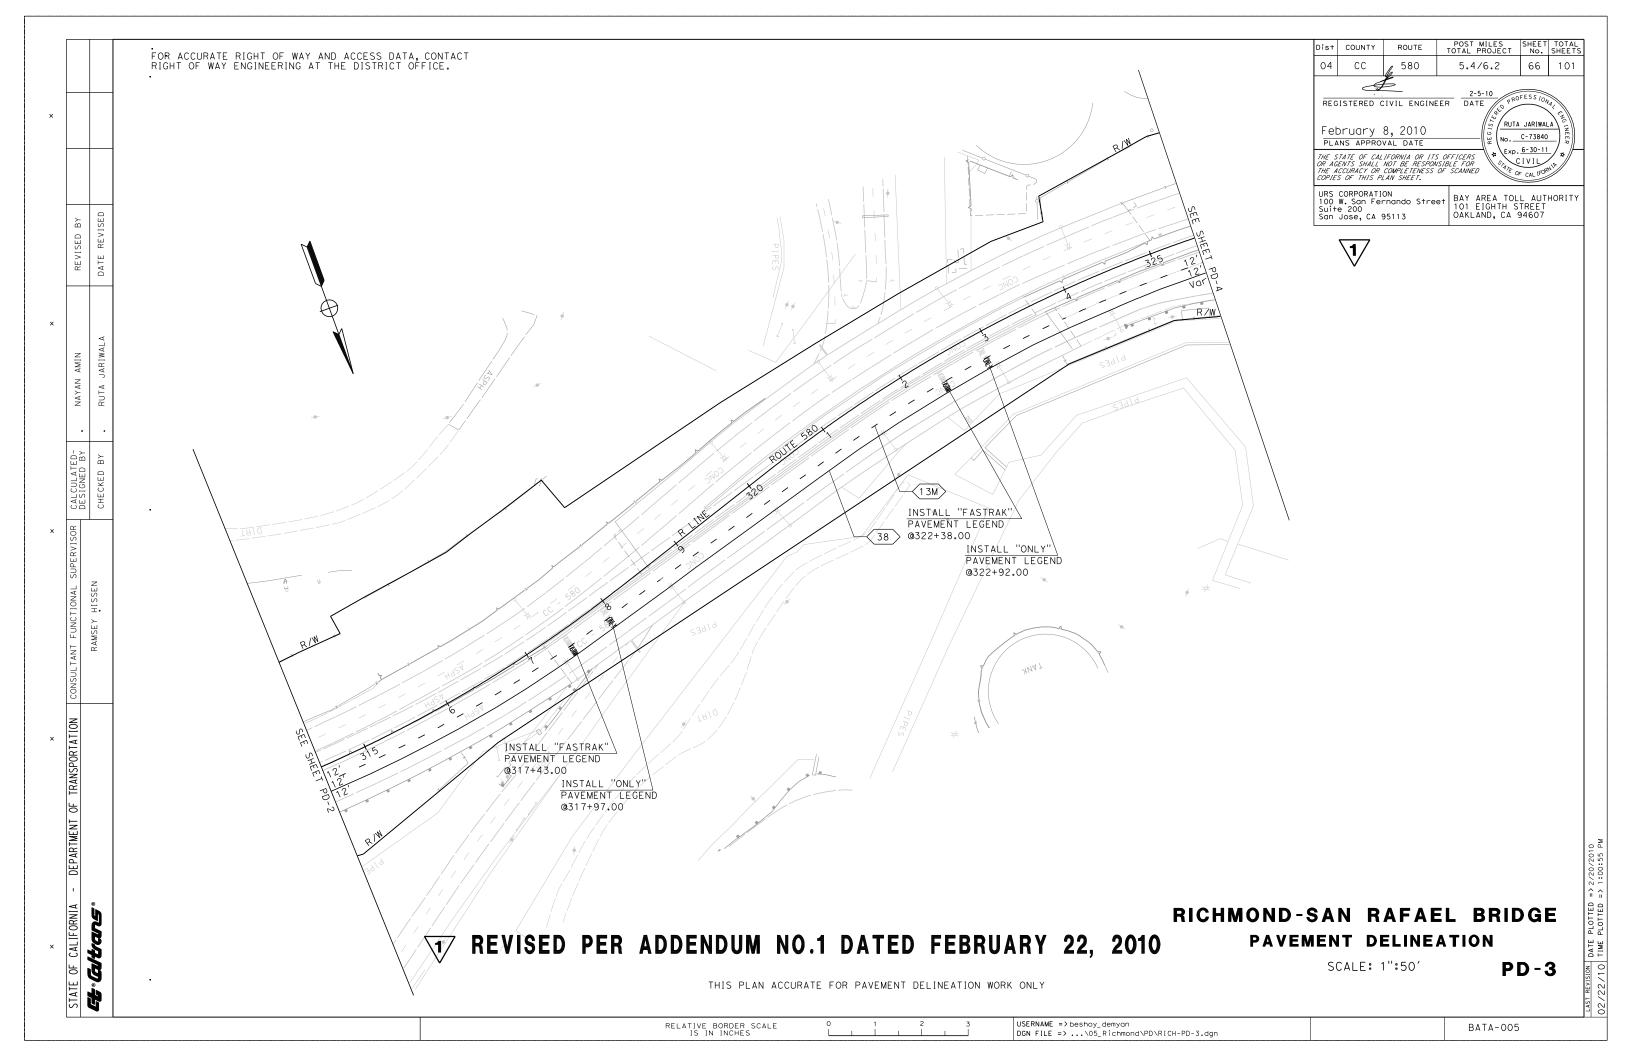

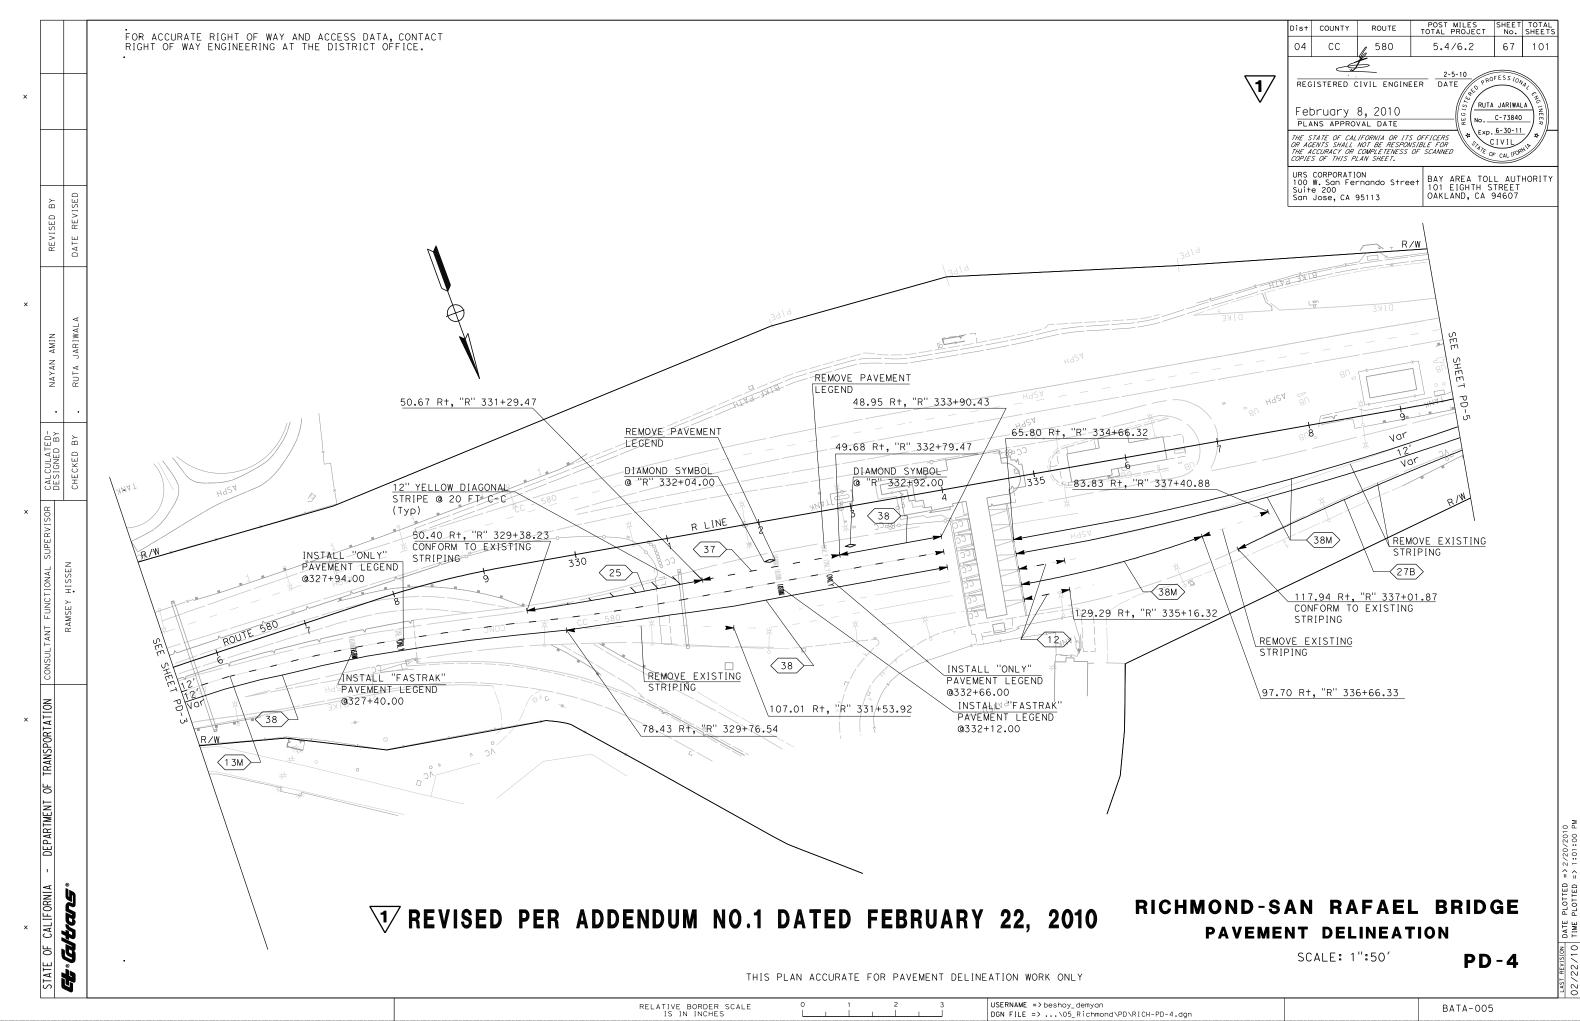

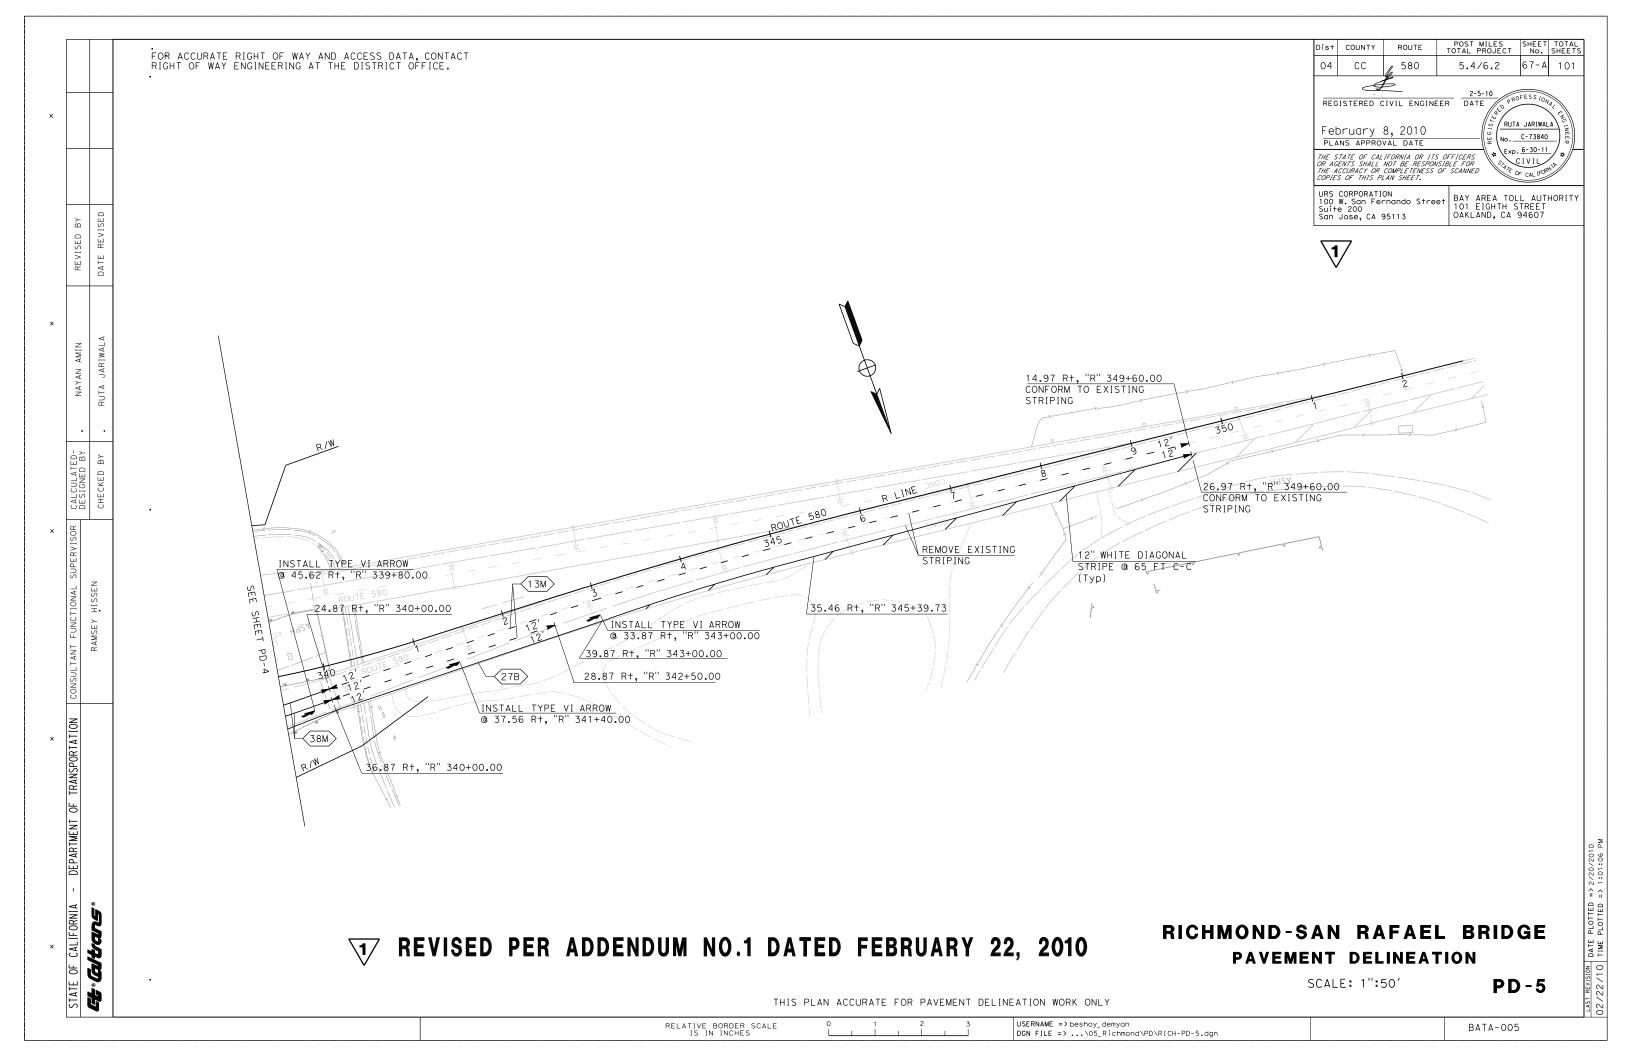



Dist COUNTY ROUTE 04 CC 580 5.4/6.2 68 £ REGISTERED CIVIL ENGINEER DATE

February 8, 2010 PLANS APPROVAL DATE

THE STATE OF CALIFORNIA OR ITS OFFICERS OR AGENTS SHALL NOT BE RESPONSIBLE FOR THE ACCURACY OR COMPLETENESS OF SCANNED COPIES OF THIS PLAN SHEET.

URS CORPORATION 100 W. San Fernando Street Suite 200 San Jose, CA 95113

BAY AREA TOLL AUTHORITY 101 EIGHTH STREET OAKLAND, CA 94607

RUTA JARIWALA

No. C-73840 Exp. 6-30-11

CIVIL

#### PAVEMENT DELINEATION QUANTITIES

					PAVEMENT MARKER				THERMOPLASTIC TRAFFIC STRIPE					PAVEMEN ⁻	MARKING		REMOVE				
		ATION			NON-	NON-						2)	8 in WHITE SOLID	THERMOPLASTIC	PAI	NT		REMOVE			
SHEET				NGTH	REFLE- CTIVE				SOLID	SOLID	8 in (WHITE BROKEN 12-3)	I			i.i.	z in LLOW	THERMOPLASTIC TRAFFIC	PAINT TRAFFIC	PAVEMENT MARKER	PAVEMENT MARKING	
No.	STATION LIMITS		DETAIL NO. OR PAVEMENT MARKING	LEN	TYPE A or	TYPE	PE TYPE T		L OW	4 in WHITE	Z Z	Z Z Z Z Z Z	In W	RMOF		12 WHI 12 YEL	STRIPE S	STRIPE	MARKER	WARRING	
					AY	С	G	Н	4 YEI	4 WHI	8 BR(	4 BRC	8 SO	H	DIAG STR	IPE	WHITE YELLOW	WHITE	ALL TYPES	ALL TYPES	
				LF	EΑ	EΑ	EΑ	EΑ	LF	LF		LF	LF		SQFT	SQFT	LF LF	LF	EΑ	SQFT	
PD-1	"R" 293+50 TO 301+50 WB	R+	1 3M	800	67		18					800					800		84		
	"R" 293+50 TO 301+50 WB	R†	37	800			55				800						800		55		
	"R" 293+89 TO 294+97 WB		"FASTRAK LANE AHEAD"											98							
	"R" 298+56 TO 299+64 WB		"FASTRAK LANE AHEAD"											98							
PD-2	"R" 301+50 TO 314+50 WB	R†	1 3M	1300	108		28					1300					1300		136		
	"R" 301+50 TO 306+49.07 WB	R†	37	499		8	28				499						499		36		
	"R" 306+49.07 TO 314+50 WB	R+	38	801			34						801				801		34		
	"R" 303+48 TO 304+56 WB		"FASTRAK LANE AHEAD"											98							
DD 3	"R" 308+63 TO 309+17 WB	R+	"FASTRAK ONLY"	1100	0.0		0.4					1100		65			1100		4.4.6		
PD-3	"R" 314+50 TO 325+50 WB "R" 314+50 TO 325+50 WB	R†	1 3M 38	1100	92		24 47					1100	1100				1100		116 47	$\vdash$	
	"R" 317+43 TO 317+97 WB	R†	"FASTRAK ONLY"	1100			47						1100	CE			1100		4 /		
	"R" 322+38 TO 322+92 WB	R†	"FASTRAK ONLY"											65 65						<del></del>	
PD-4		R†	38	111			6						111	65			111		6	<del>                                     </del>	
' ' '	"R" 325+50 TO 333+90.43 WB	R†	38	840			36						840				840		36		
-	"R" 325+50 TO 333+90.43 WB	R†	1 3M	840	70		19					840	040				840		89	<del>                                     </del>	
	"R" 329+38.23 TO 331+29.47 WB		25	191	10		13	5	191			070					191		5		
	"R" 331+29.47 TO 332+79.47 WB	R†	37	150		8	5		131		150						150		13		
	"R" 334+66.32 TO 339+50 WB	R†	38M	967			41			967	130						967		41		
	"R" 334+66.32 TO 335+16.32 WB		12	100			3					100					100		3		
	"R" 334+66.32 TO 336+66.33 WB		38M	200			9			200							200		9		
	"R" 337+01.87 TO 339+50 WB	R†	27B	248						248							248		·		
	"R" 329+38.23 TO 331+29.47 WB	R+	YELLOW DIAGONAL													51					
	"R" 332+04 WB	R+	DIAMOND SYMBOL											11							
	"R" 332+92 WB	R+	DIAMOND SYMBOL											11							
	"R" 329+76.54 TO 331+53.92 WB			177													177		5		
	"R" 336+66.33 TO 337+40.88 WB			75													75		3		
	"R" 332+12.00 TO 332+66.00 WB		"FASTRAK ONLY"											65						65	
	"R" 327+40.00 TO 327+94.00 WB		"FASTRAK ONLY"				_			100				65							
PD-5		R+	38M	100			5			100		250					100		5		
	"R" 340+00.00 TO 342+50.00 WB		1 3M 1 3M	250	21		6					250	-	1			250		27	<del>                                     </del>	
	"R" 340+00.00 TO 349+60.00 WB		27B	960 1010	80		21			1010		960	-	-	-		960		101	<del>                                     </del>	
	"R" 339+80.00 WB	R†	TYPE VI ARROW	1010						1010			-	42	-		1010			<del>                                     </del>	
	"R" 341+40.00 WB	R†	TYPE VI ARROW							-			-	42	-					<del>                                     </del>	
-	"R" 343+00.00 WB	R†	TYPE VI ARROW							-			<del>                                     </del>	42	-					<del>                                     </del>	
	"R" 343+00.00 TO 349+60.00 WB		WHITE DIAGONAL							-				+ 44	180			255		<del>                                     </del>	
	TOTAL	1111	IIL DIAGONAL		438	16	386	5	191	2526	1449	5350	2852	767	180	51	12429 191	<u>255</u> 255	851	65	
	TOTAL					, 0	. 550		1	,	1	0000					1.2.23		551		

RICHMOND-SAN RAFAEL BRIDGE **PAVEMENT DELINEATION** QUANTITIES

TREVISED PER ADDENDUM NO.1 DATED FEBRUARY 22, 2010

PDQ-1


RAMSEY HISSEN


DEPARTMENT OF TRANSPORTATION


CALIFORNIA


G Cutrans

USERNAME => beshoy_demyan
DGN FILE => ...\05_Richmond\PD\RICH-PDQ-1.dgn

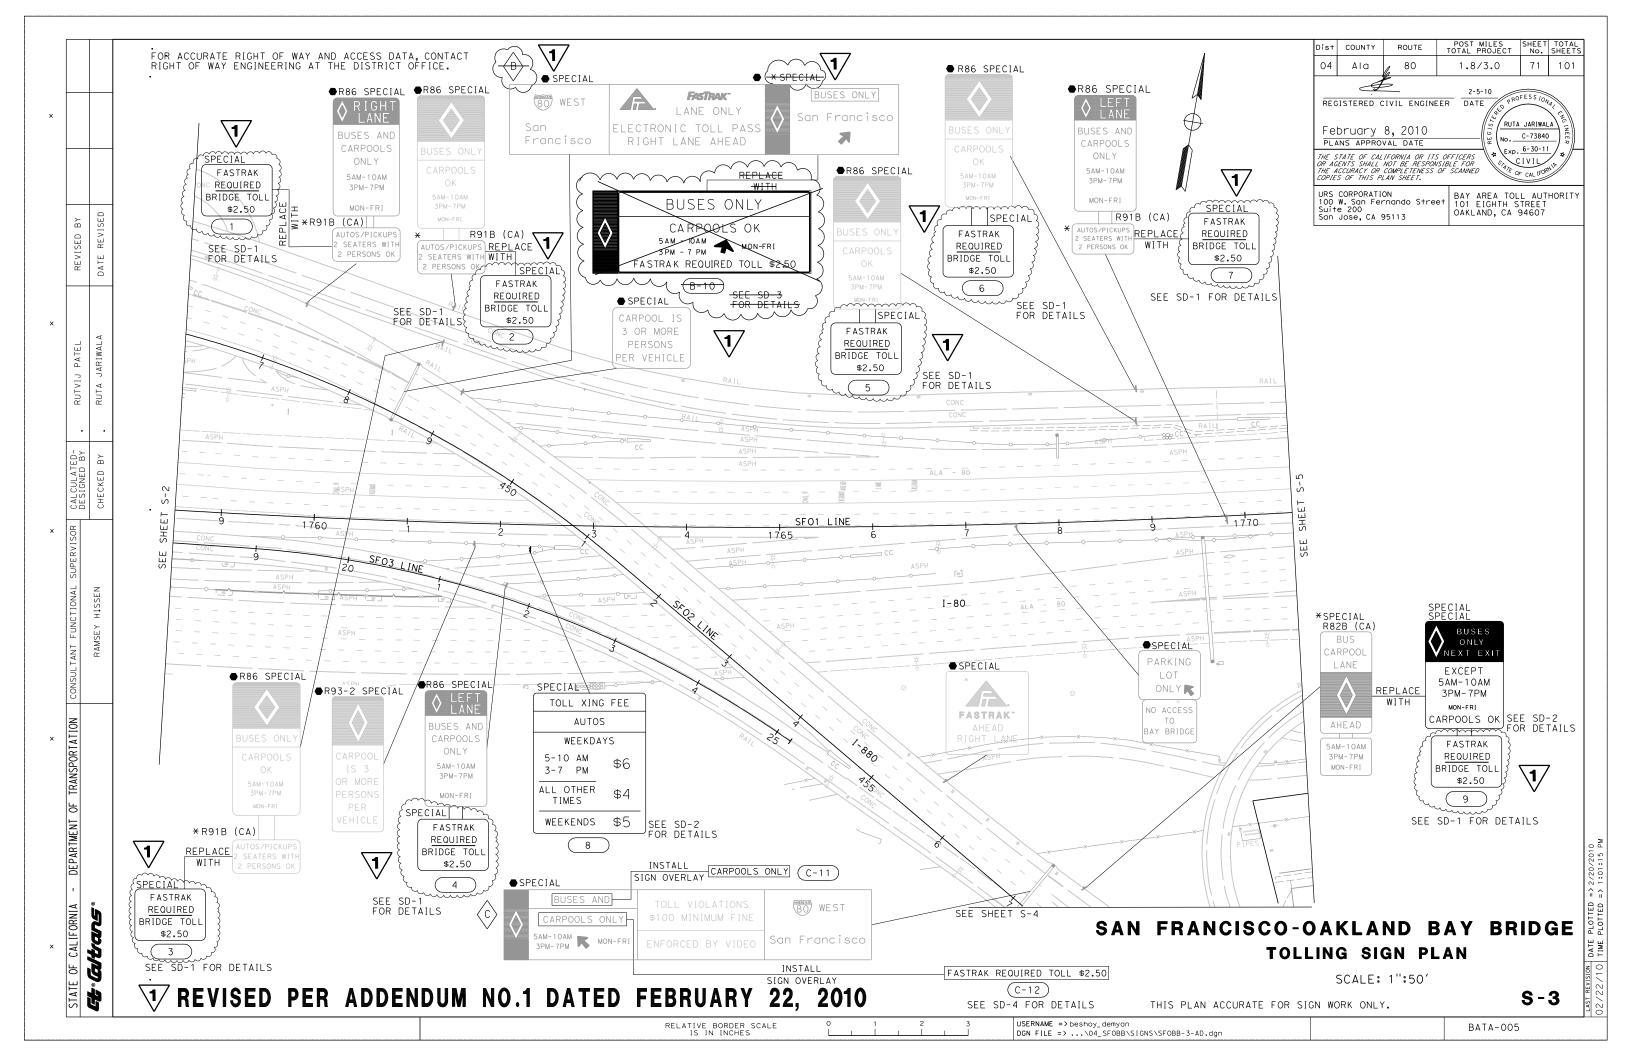

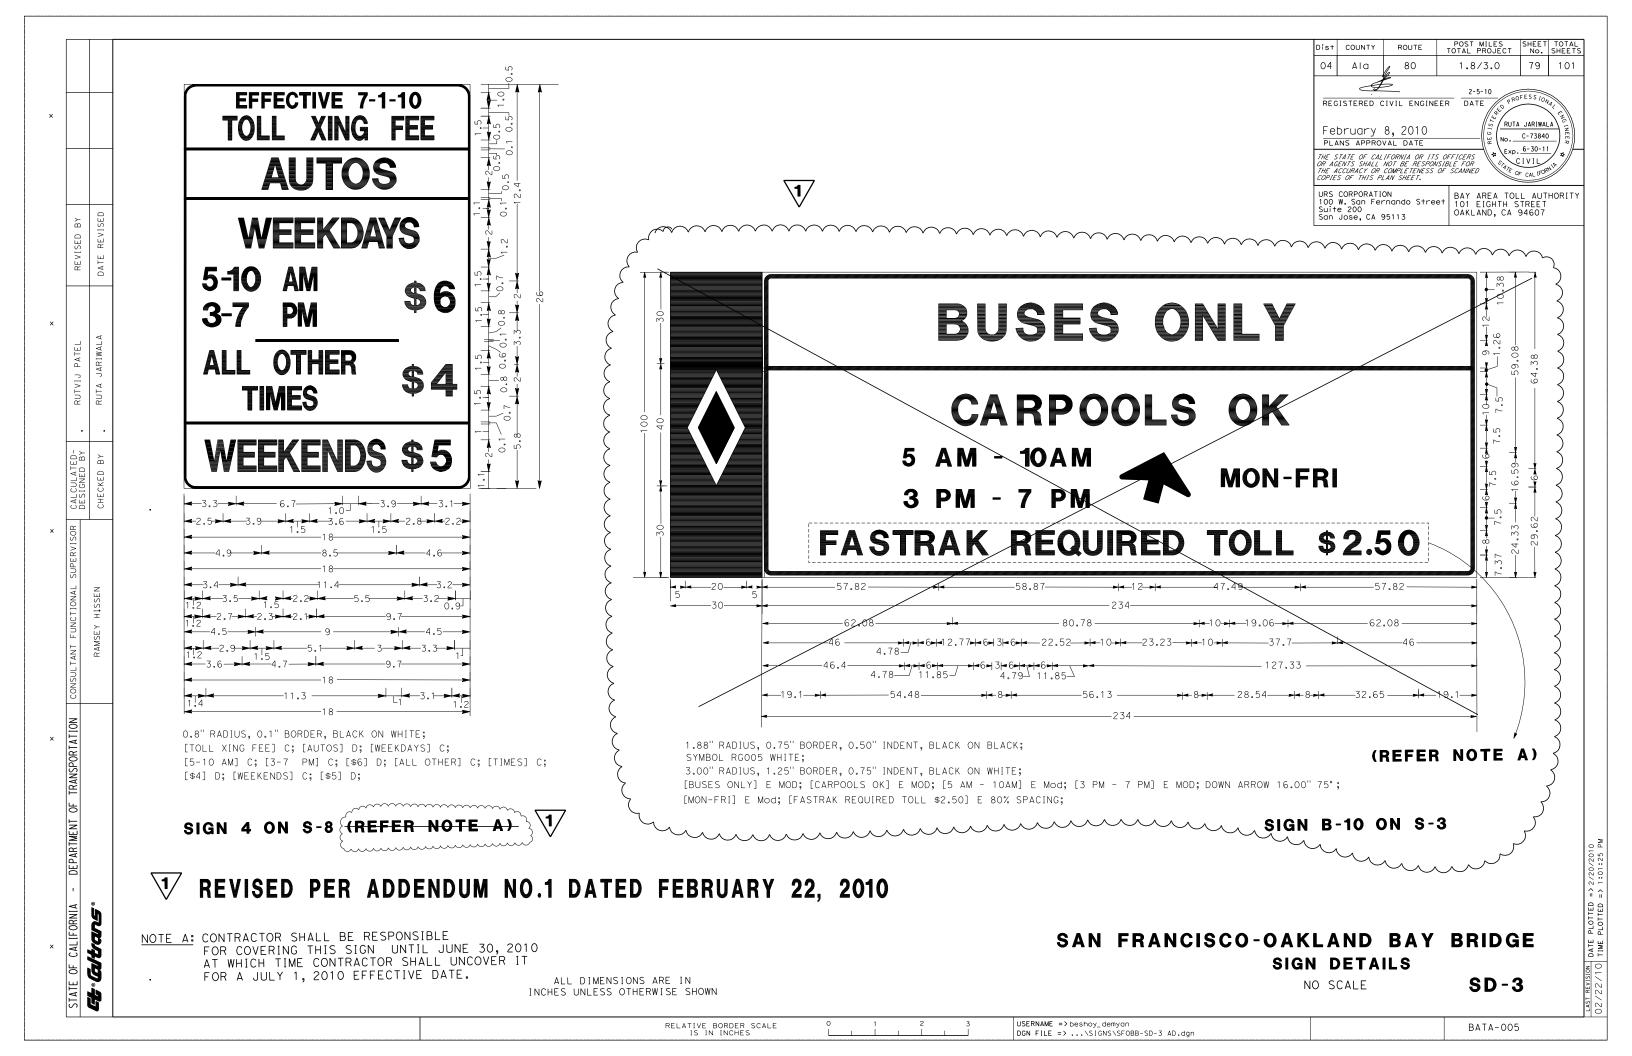

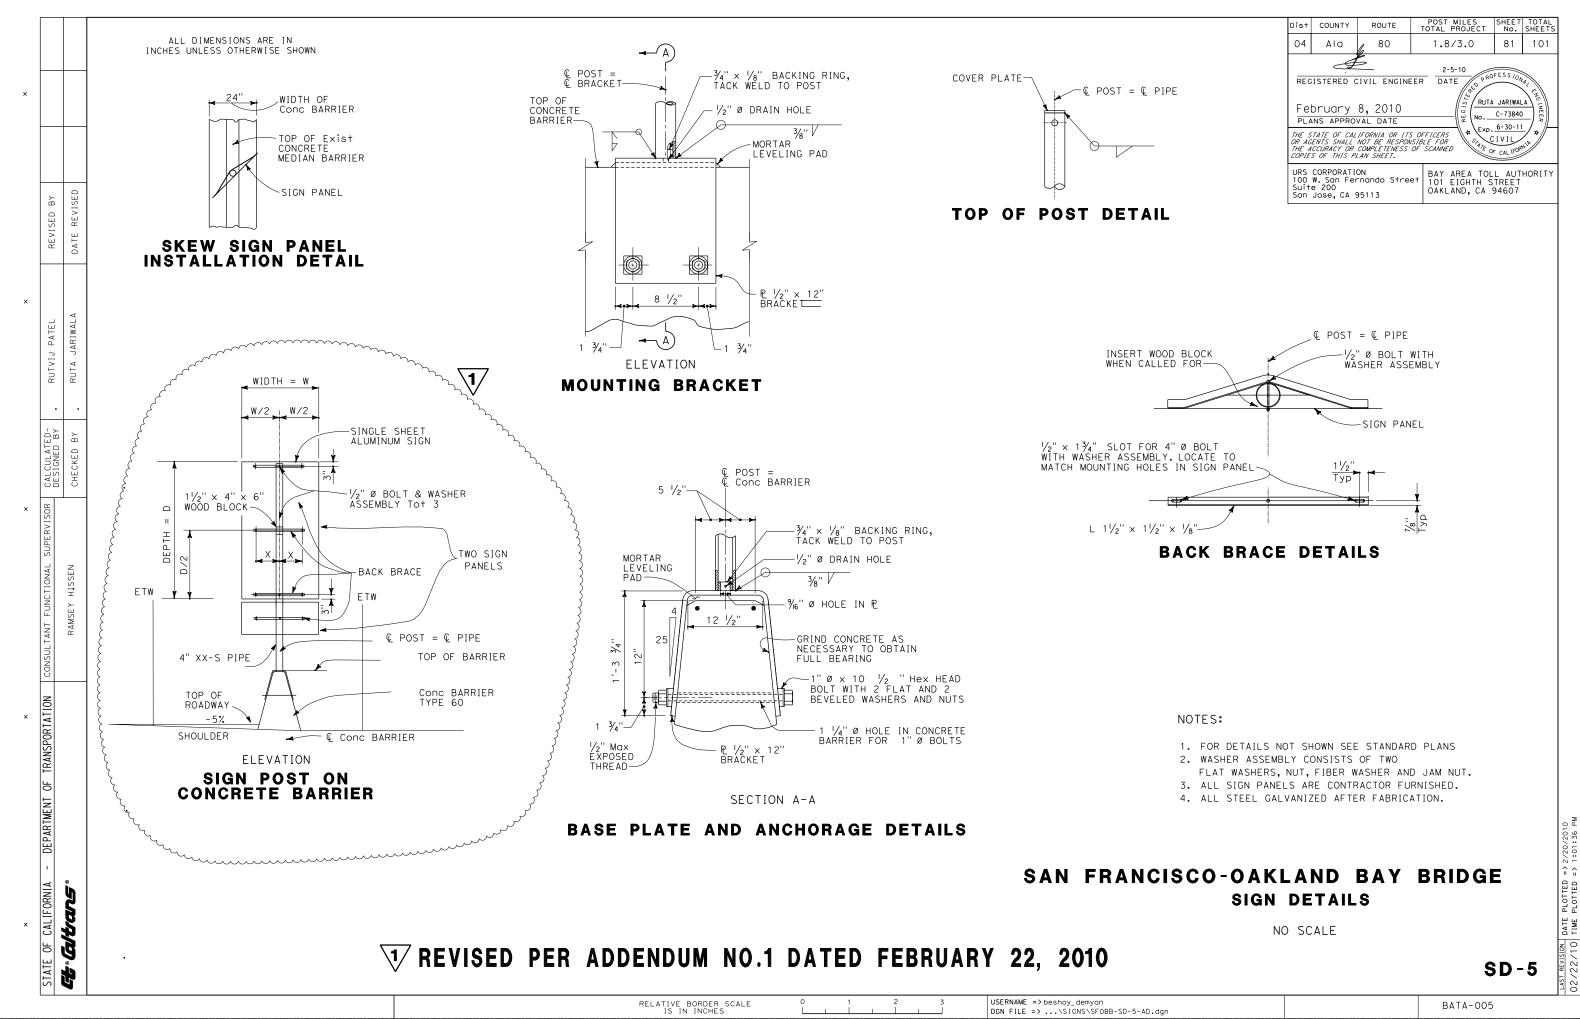

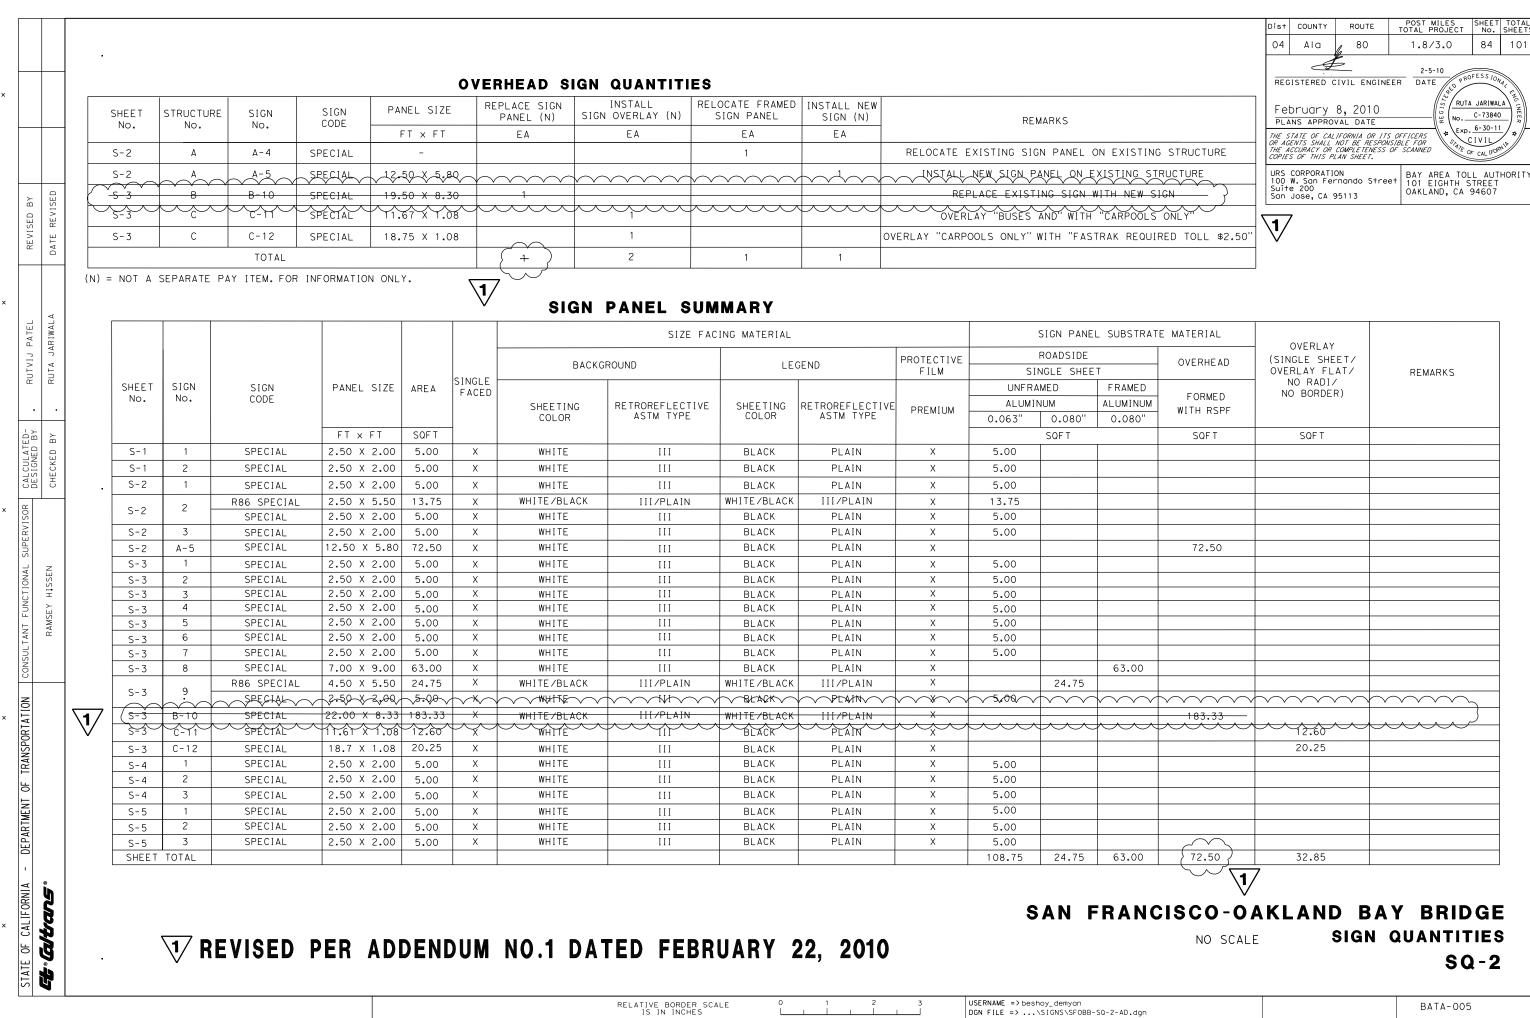

POST MILES SHEET TOTAL TOTAL PROJECT No. SHEETS Dist COUNTY ROUTE 04 80 1.8/3.0 85 Ala  $\mathcal{F}$ REGISTERED CIVIL ENGINEER DATE RUTA JARIWALA February 8, 2010 PLANS APPROVAL DATE No. C-73840 Exp. 6-30-11 THE STATE OF CALIFORNIA OR ITS OFFICERS OR AGENTS SHALL NOT BE RESPONSIBLE FOR THE ACCURACY OR COMPLETENESS OF SCANNED COPIES OF THIS PLAN SHEET. CIVIL URS CORPORATION 100 W. San Fernando Street Suite 200 San Jose, CA 95113 BAY AREA TOLL AUTHORITY 101 EIGHTH STREET OAKLAND, CA 94607 REVISED SIGN PANEL SUMMARY SIZE FACING MATERIAL SIGN PANEL SUBSTRATE MATERIAL OVERLAY ROADSIDE PROTECTIVE OVERHEAD BACKGROUND LEGEND (SINGLE SHEET/ FILM SINGLE SHEET OVERLAY FLAT/ REMARKS SINGLE SIGN SIGN PANEL SIZE AREA UNFRAMED FRAMED NO RADI/ FACED CODE FORMED NO BORDER) RETROREFLECTIVE ASTM TYPE SHEETING COLOR RETROREFLECTIVE ASTM TYPE ALUMINUM ALUMINUM SHEETING PREMIUM WITH RSPF COLOR 0.063 0.080" 0.080" FT x FT SQFT SQFT SQFT SQFT S-6 SPECIAL 2.50 X 2.00 5.00 WHITE IIIBLACK PLAIN 5.00

PLAIN

PLAIN

BLACK

BLACK

III

HI

III

III

III

III

TREVISED PER ADDENDUM NO.1 DATED FEBRUARY 22, 2010

WHITE

WHITE

SPECIAL

SPECIAL

4

SHEET TOTAL

TOTAL

DEPARTMENT OF TRANSPORTATION

CALIFORNIA

Et altars

2.50 X 2.00

2.50 X 2.00

7.00 X 9.00

2.50 X 2.00

.50 X 0.25

1.75 X 0.17

1.50 X 2.00

5.00

63.00

5.00

0.38

0.30

3.00

Χ

SAN FRANCISCO-OAKLAND BAY BRIDGE
NO SCALE SIGN QUANTITIES

 $0.38 \times 18 = 6.84$ 

0.30 X 18 = 5.40

12.24

45.09

**SQ-3** 

BATA-005

RELATIVE BORDER SCALE 0 1 2 3 USERNAME => beshoy_demyan
IS IN INCHES DGN FILE => ...\SIGNS\SFOBB-SO-3.-ADdgn

5.00

5.00

3.00 X 18=54.00

74.0

182.75

63.00

63.00

126.00

72.50

1

24.75


Χ

Χ

Χ

Χ

LAST REVISION DATE PLOTTED => 2/20/2

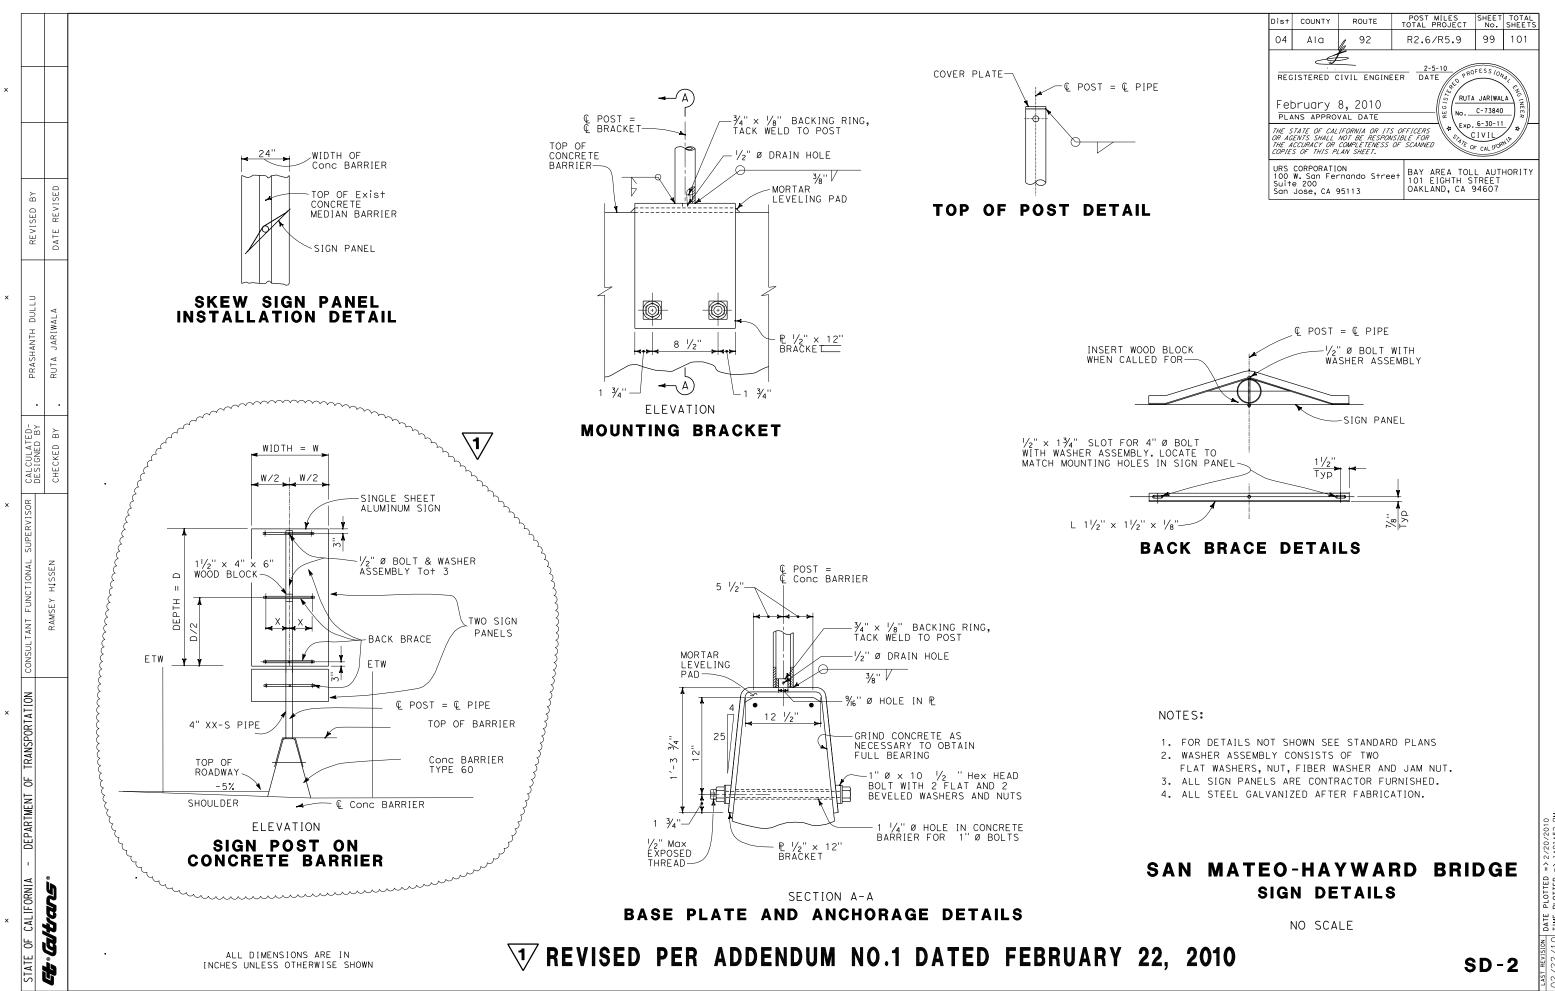

BATA-005

USERNAME => beshoy_demyan
DGN FILE => ...\07_SanMa+eo\SIGNS\SM-SD-2.dgn